


T.16S., R.5W., W.M.

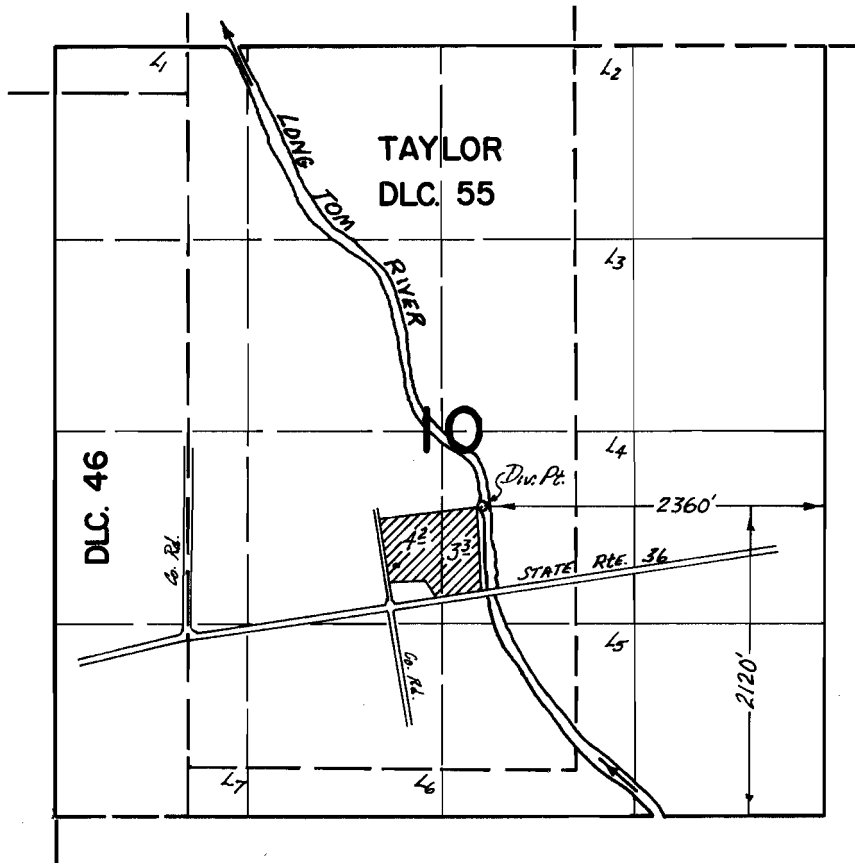

FINAL PROOF SURVEY UNDER

Application No. 44457 Permit No. 33251
IN NAME OF

PAUL R. ZINK

Surveyed 27 Sept. 1972, by D. NORBY