


T.16S., R.6W., W.M.

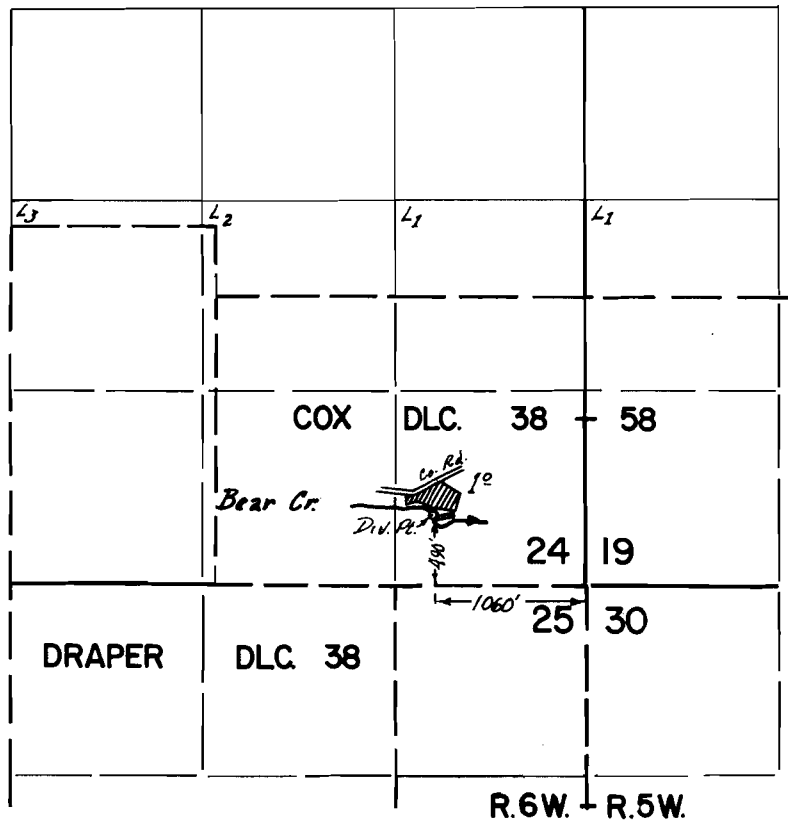

FINAL PROOF SURVEY
UNDER

Application No. 46276 Permit No. 34492
IN NAME OF

OSCAR C. BOWMAN

Surveyed 28 Sept. 1972, by D. NORBY