


T.20S. R.4 & 5 W. W.M.

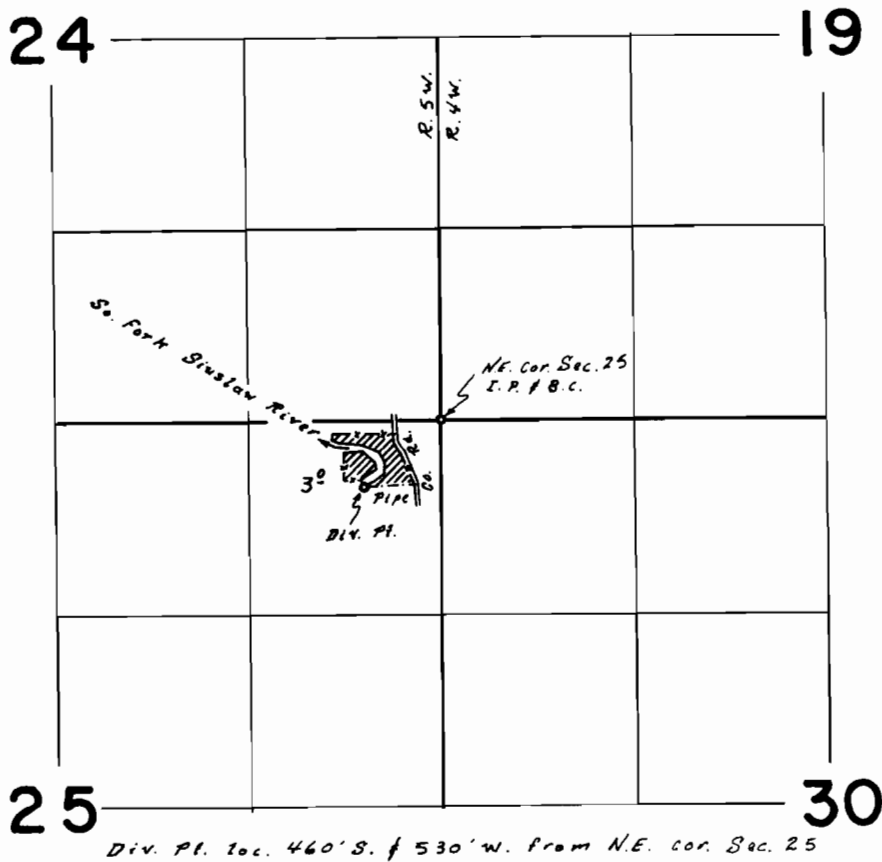

FINAL PROOF SURVEY
UNDER

Application No. 46634 Permit No. 34721
IN NAME OF

Gene R. & Dolores J. Burns

Surveyed 1 June, 1972, by L.E. Gould