


T.16S., R.6W., W.M.

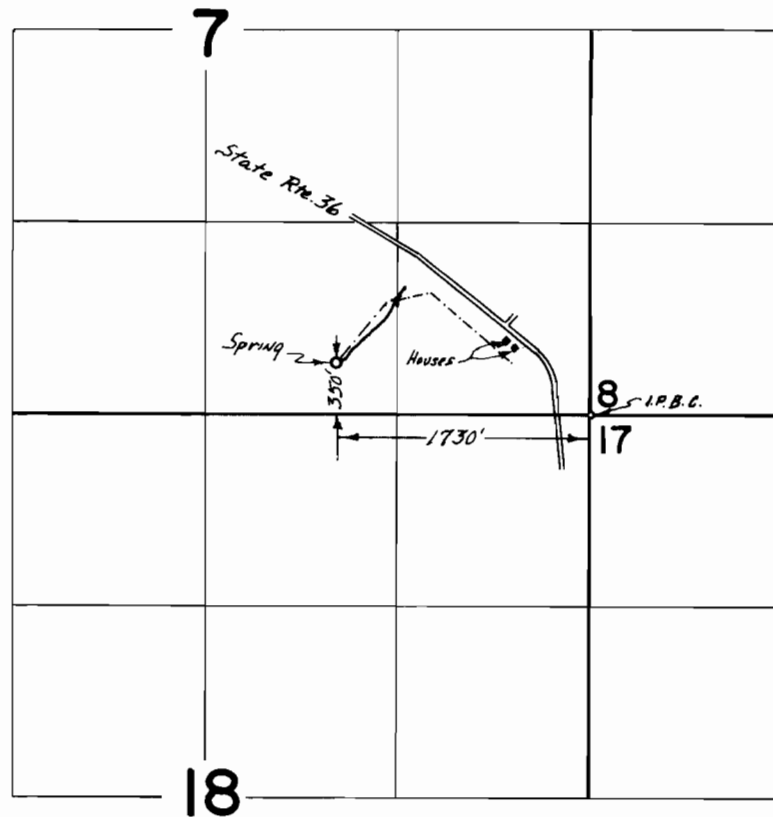

FINAL PROOF SURVEY
UNDER

Application No. 46933 Permit No. 34726
IN NAME OF

HAROLD R. & MARGARET M. AUMILLER

Surveyed 28 Sept. 1972, by D. NORBY