


T.16S., R.6W., W.M.

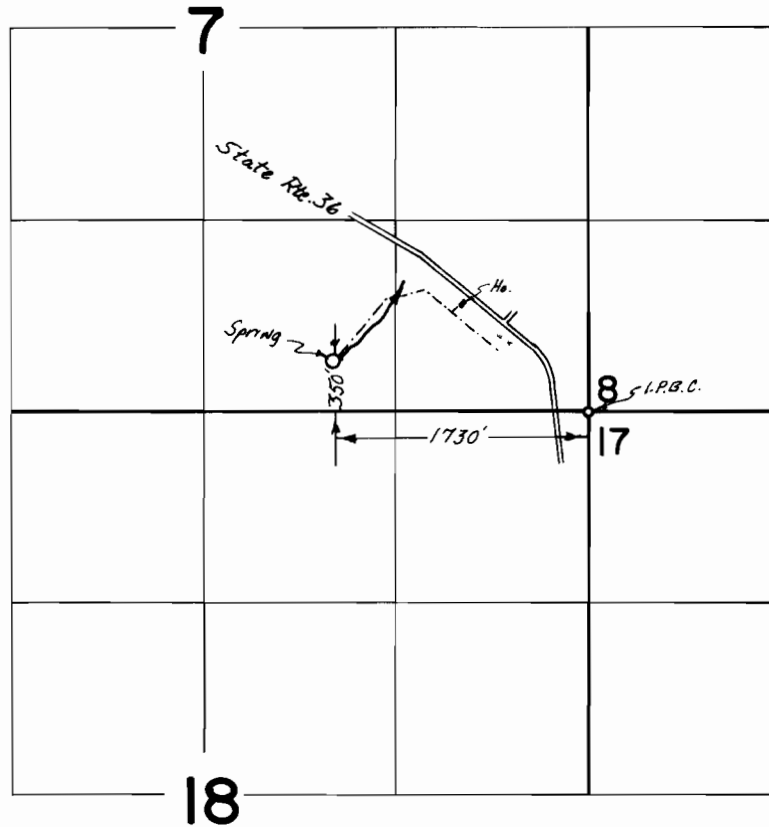

**FINAL PROOF SURVEY**  
UNDER

Application No. 46944 Permit No. 34728  
IN NAME OF

RAYMOND E. & ALLEGRA GROSHONG

Surveyed 28 Sept. 1972, by D. NORBY