


T.16S., R.6W., W.M.

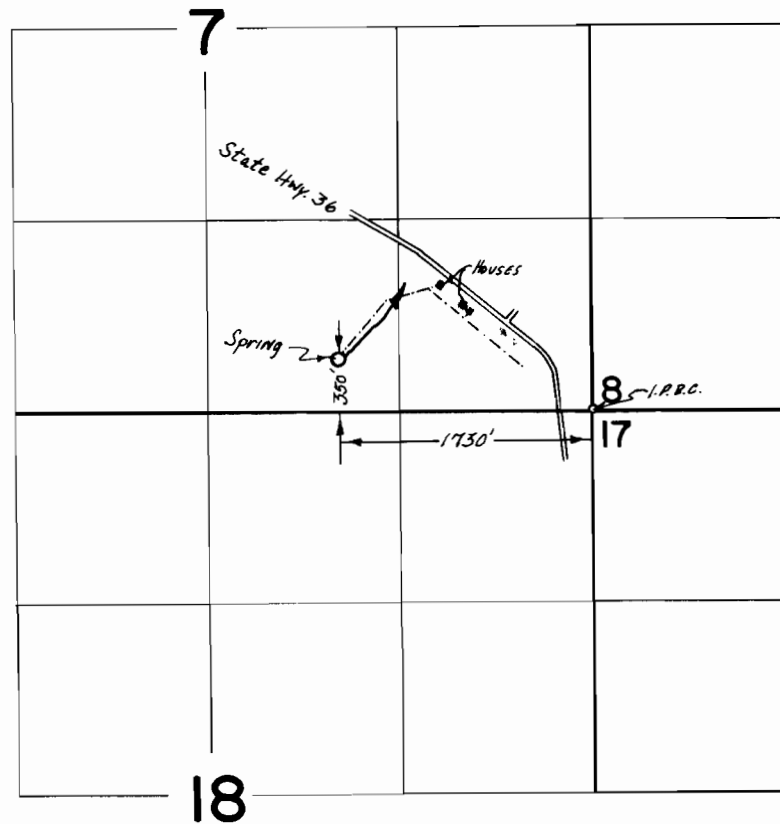

FINAL PROOF SURVEY
UNDER

Application No. 46945 Permit No. 34729
IN NAME OF

DeWANE W. & GWEN KEENEY

Surveyed 28 Sept. 19.72 by D. NORBY