T. 16 S., R. 5 W., W.M.

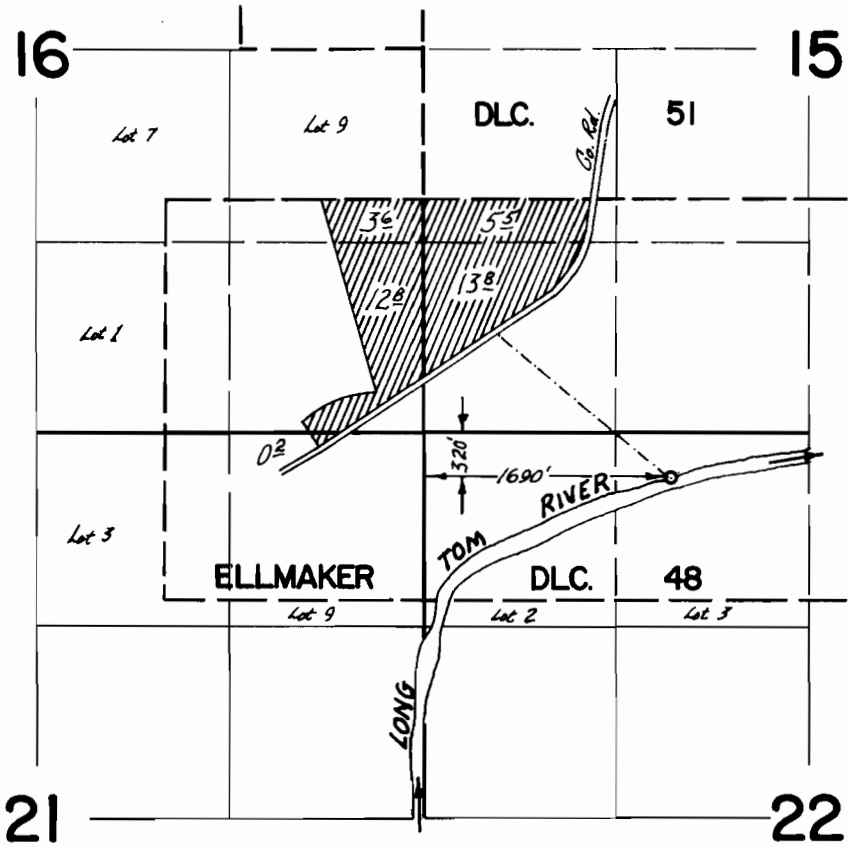

FINAL PROOF SURVEY
UNDER

Application No. 46676 Permit No. 34871
IN NAME OF

R. A. SIEWART

Surveyed 29 Sept. 19 72, by D. NORBY

DBQ-255-190