


T. 15S., R. 5 W., W.M.

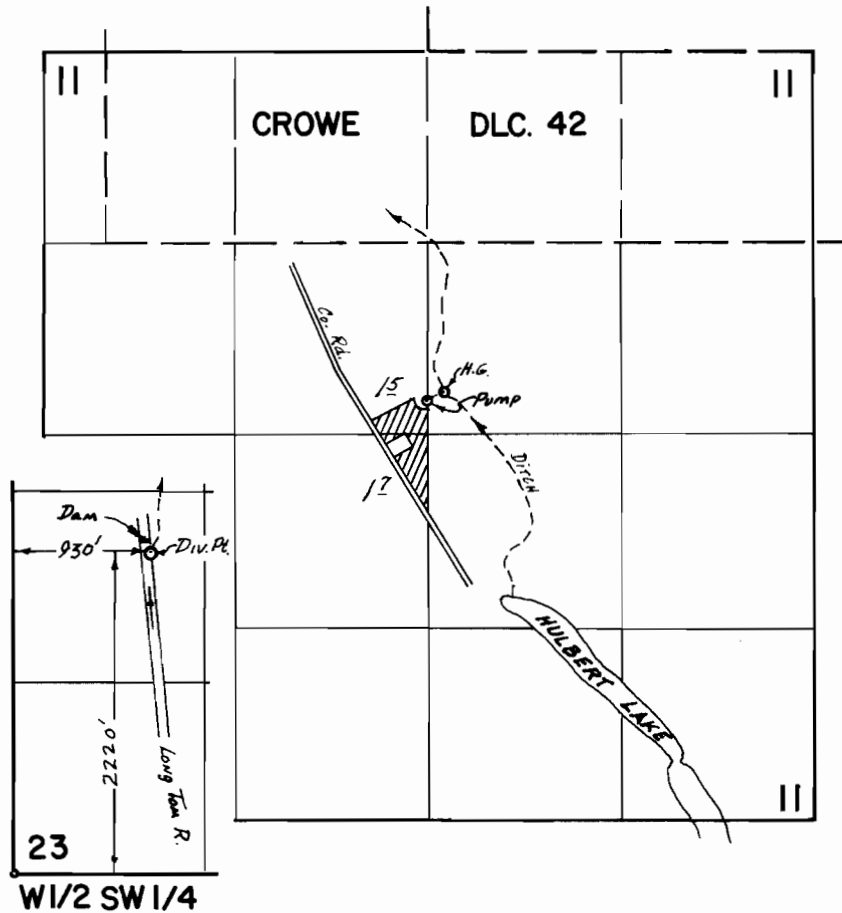

FINAL PROOF SURVEY
UNDER

Application No. 44847 Permit No. 35699
IN NAME OF

CLIFFORD H. & OLLIE B. CLEVELAND

Surveyed 26 Sept. 1972, by D. NORBY