


T.12S.R.1W.W.M.

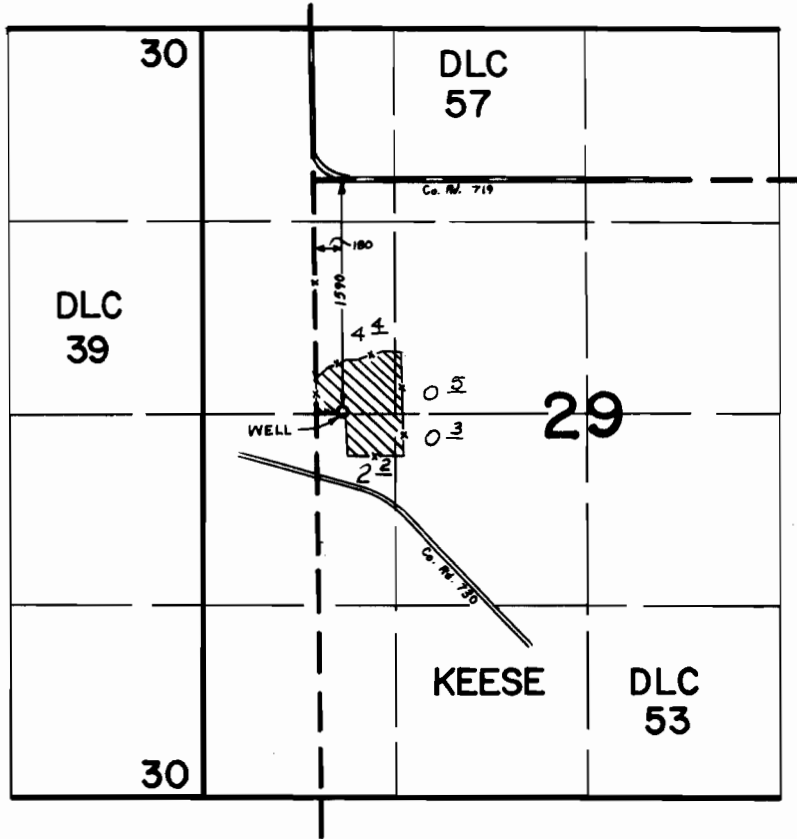

FINAL PROOF SURVEY
UNDER

Application No. G 3800 Permit No. G 3586
IN NAME OF

JUNIOR & BEVERLY OAKLEY

Surveyed MAY 23 1972, by D. BUELL