


T. 12 S. R. 2 W. W. M

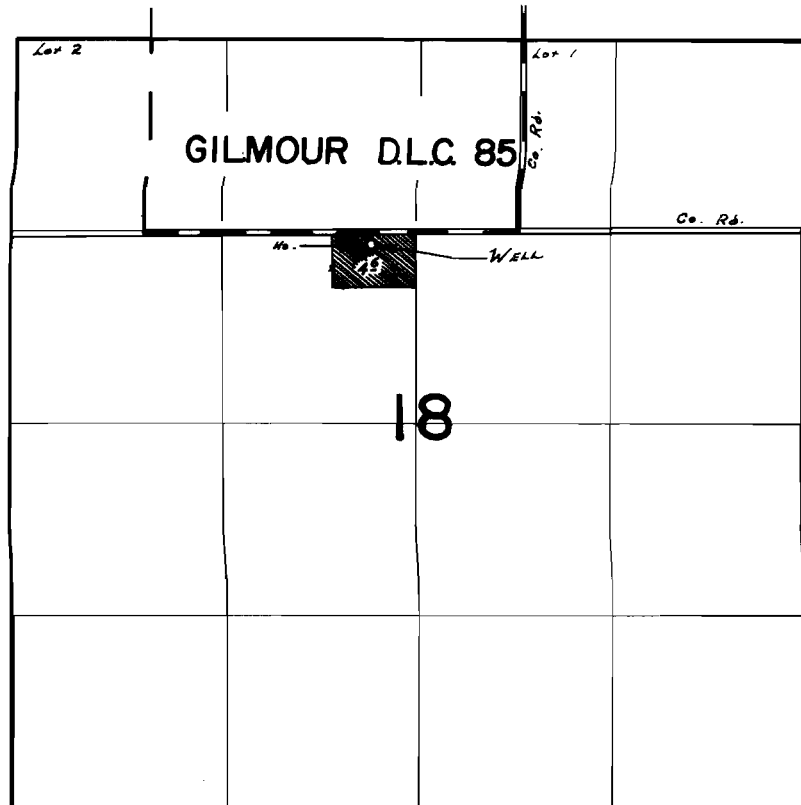

WELL Loc: 80' S & 1000' W FROM SE. COR. GILMOUR D.L.C. 85

FINAL PROOF SURVEY
UNDER

Application No. G-3895 Permit No. G-3660
IN NAME OF

ROBERT H. & H. EVELYN WHEELER

Surveyed Sec. 7 1972, by R. G. MUCKEN