


# T.I.O.S.R.I.E.W.M.

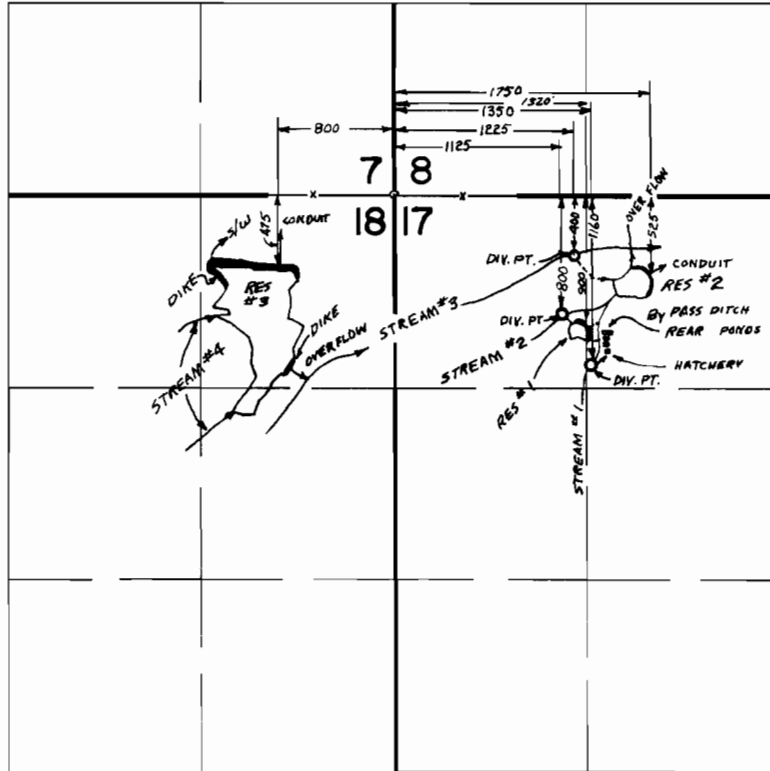

## FINAL PROOF SURVEY UNDER

Application No. 42752 R-42751 Permit No. 33131 R-5136  
IN NAME OF

BENTZ BROTHERS

Surveyed MAY 31 1972, by D. BUELL