


T. 10S. R. 1E. W.M.

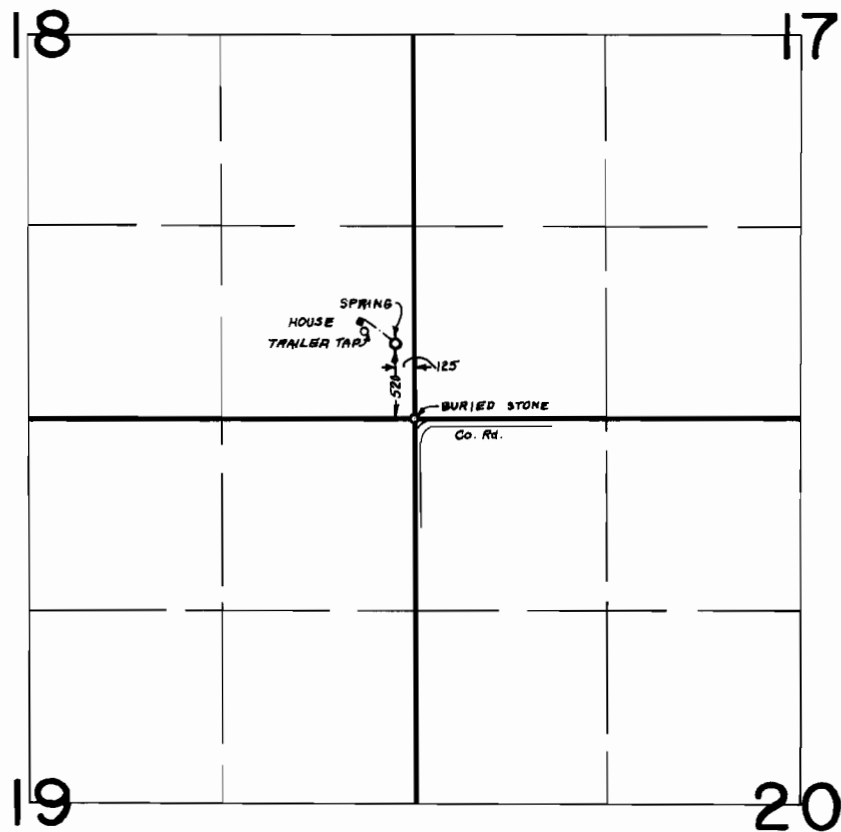

FINAL PROOF SURVEY
UNDER

Application No. 42457 Permit No. 31675
IN NAME OF

ELLA SLEDGE

Surveyed MAY 30 1972, by D. BUELL