


T.12S.R.IW.W.M.

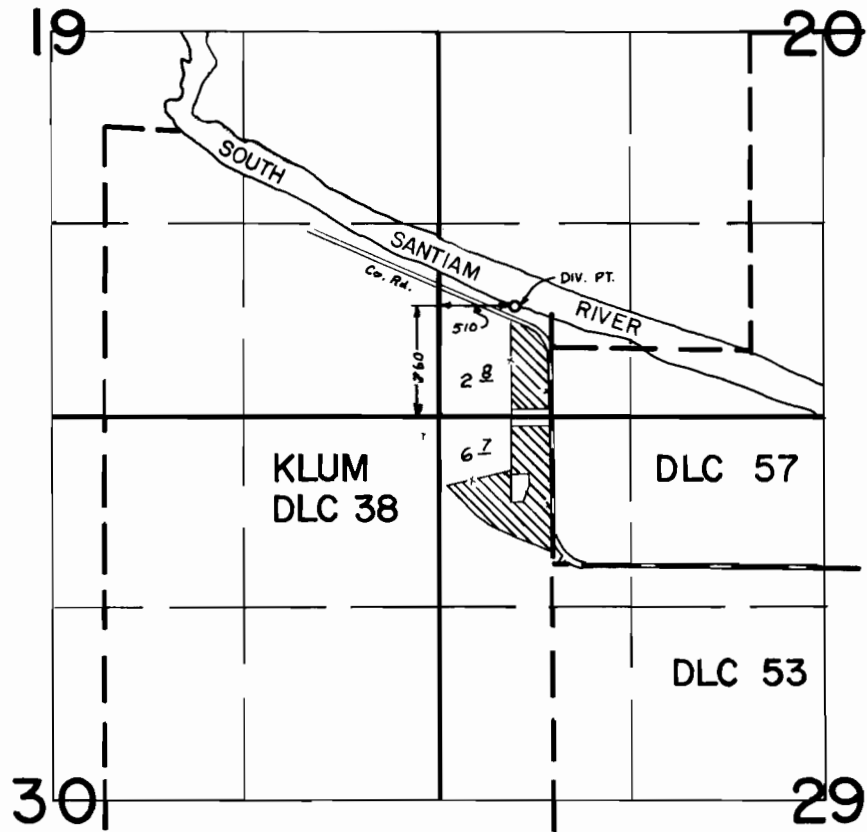

FINAL PROOF SURVEY
UNDER

Application No. 43372 Permit No. 32416
IN NAME OF

LLOYD H. GRAY & FRANCES GRAY

Surveyed MAY 22 19.72, by D. BUELL