


# T. 10S., R. 1E., W.M.

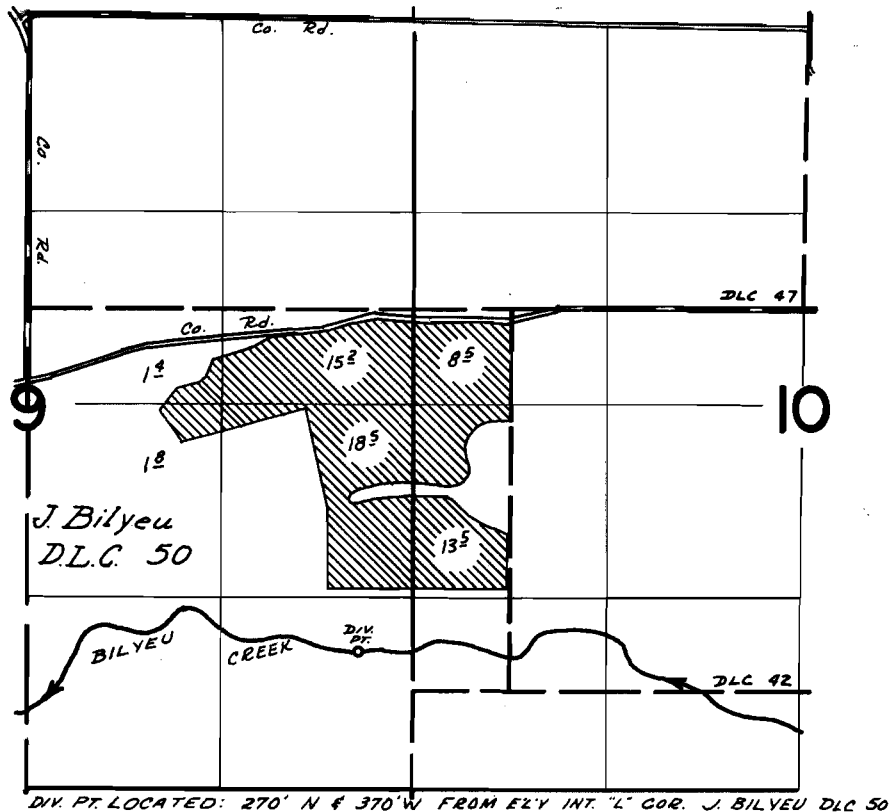

## FINAL PROOF SURVEY UNDER

Application No. 43625 Permit No. 32616  
IN NAME OF

BENNIE AND MARY ANN SILBERNAGEL

Surveyed Aug 28 1972, by D. Norby