


T. 10S. R. 1W. W.M.

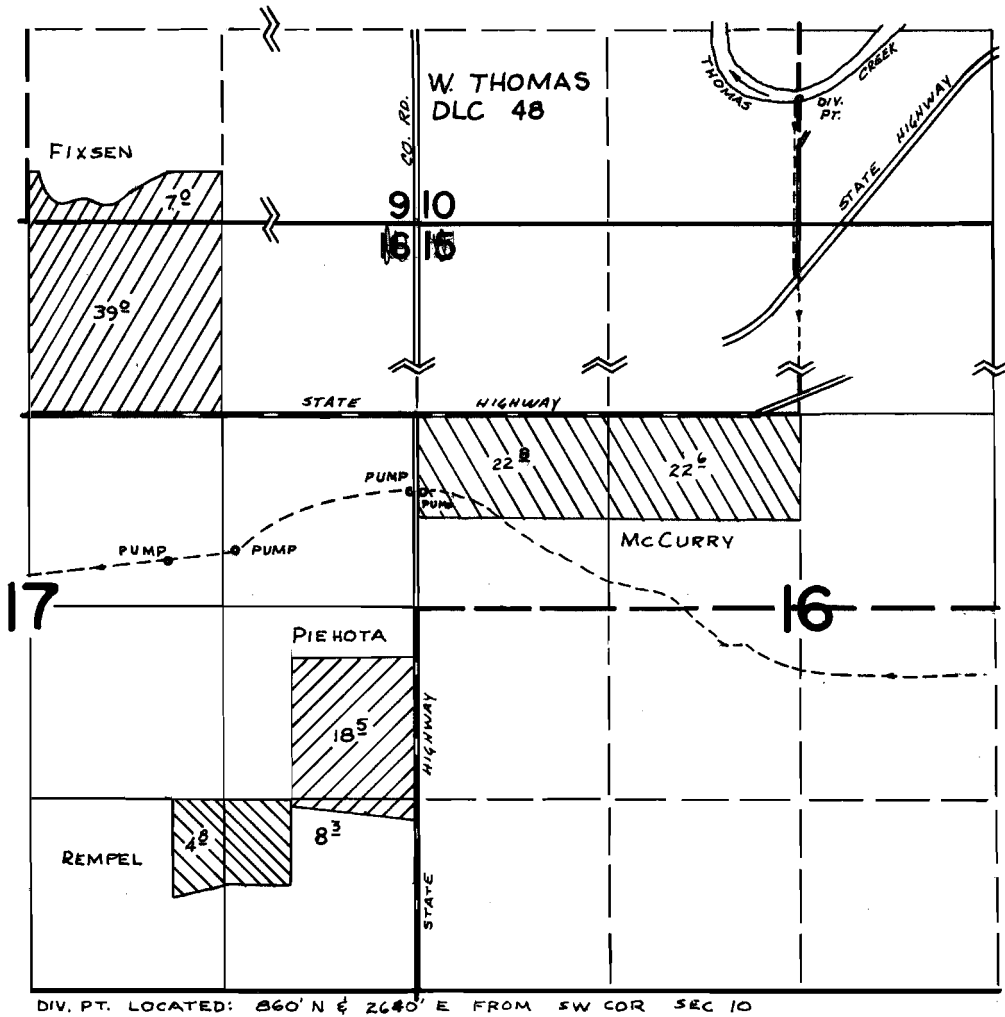

FINAL PROOF SURVEY UNDER

Application No. 43959 Permit No. 32841
IN NAME OF

SCIO WATER IMPROVEMENT DISTRICT

Surveyed SEPT 6 1972, by D. Norby