


T.10S., R.2W., W.M.

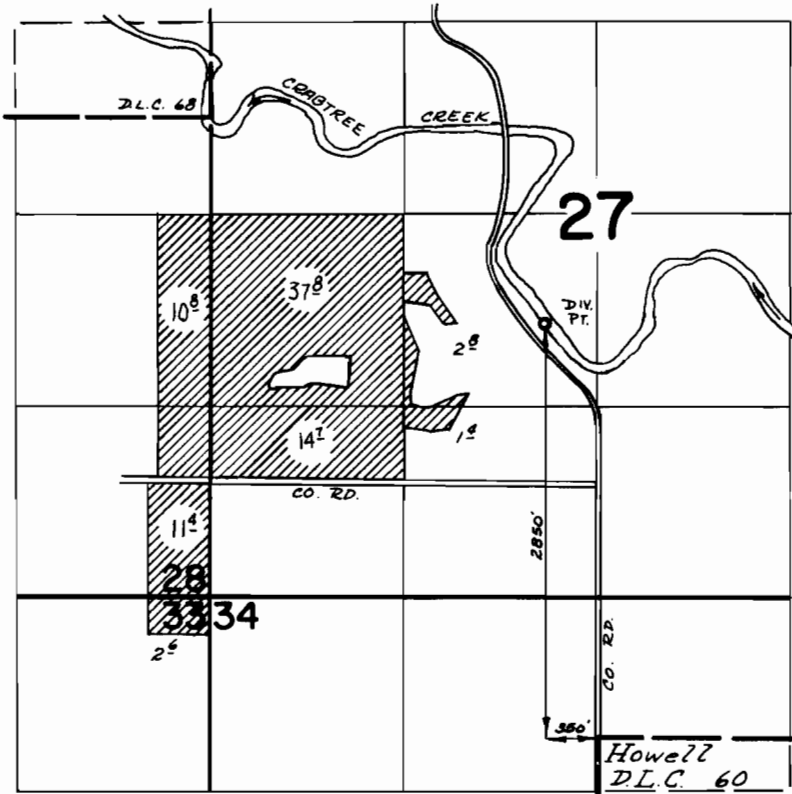

FINAL PROOF SURVEY UNDER

Application No. 45360 Permit No. 33866
IN NAME OF

HARRY C. AND SALLIE J. BOSE

Surveyed Aug 30 1972, by D. Norby