


T.11S., R.4W., W.M.

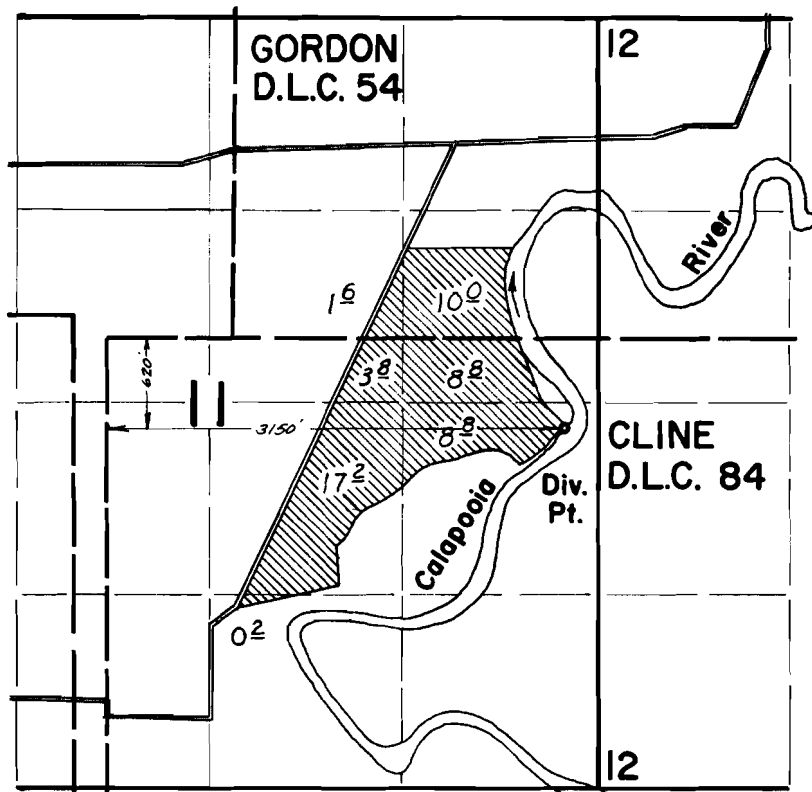

**FINAL PROOF SURVEY**  
UNDER

Application No. 45672 Permit No. 34076  
IN NAME OF

JOHN E. BRYANT

Surveyed Sept. 7, 1972, by D. Norby