


T.23 & 24 S. R.37 & 38 E. W.M.

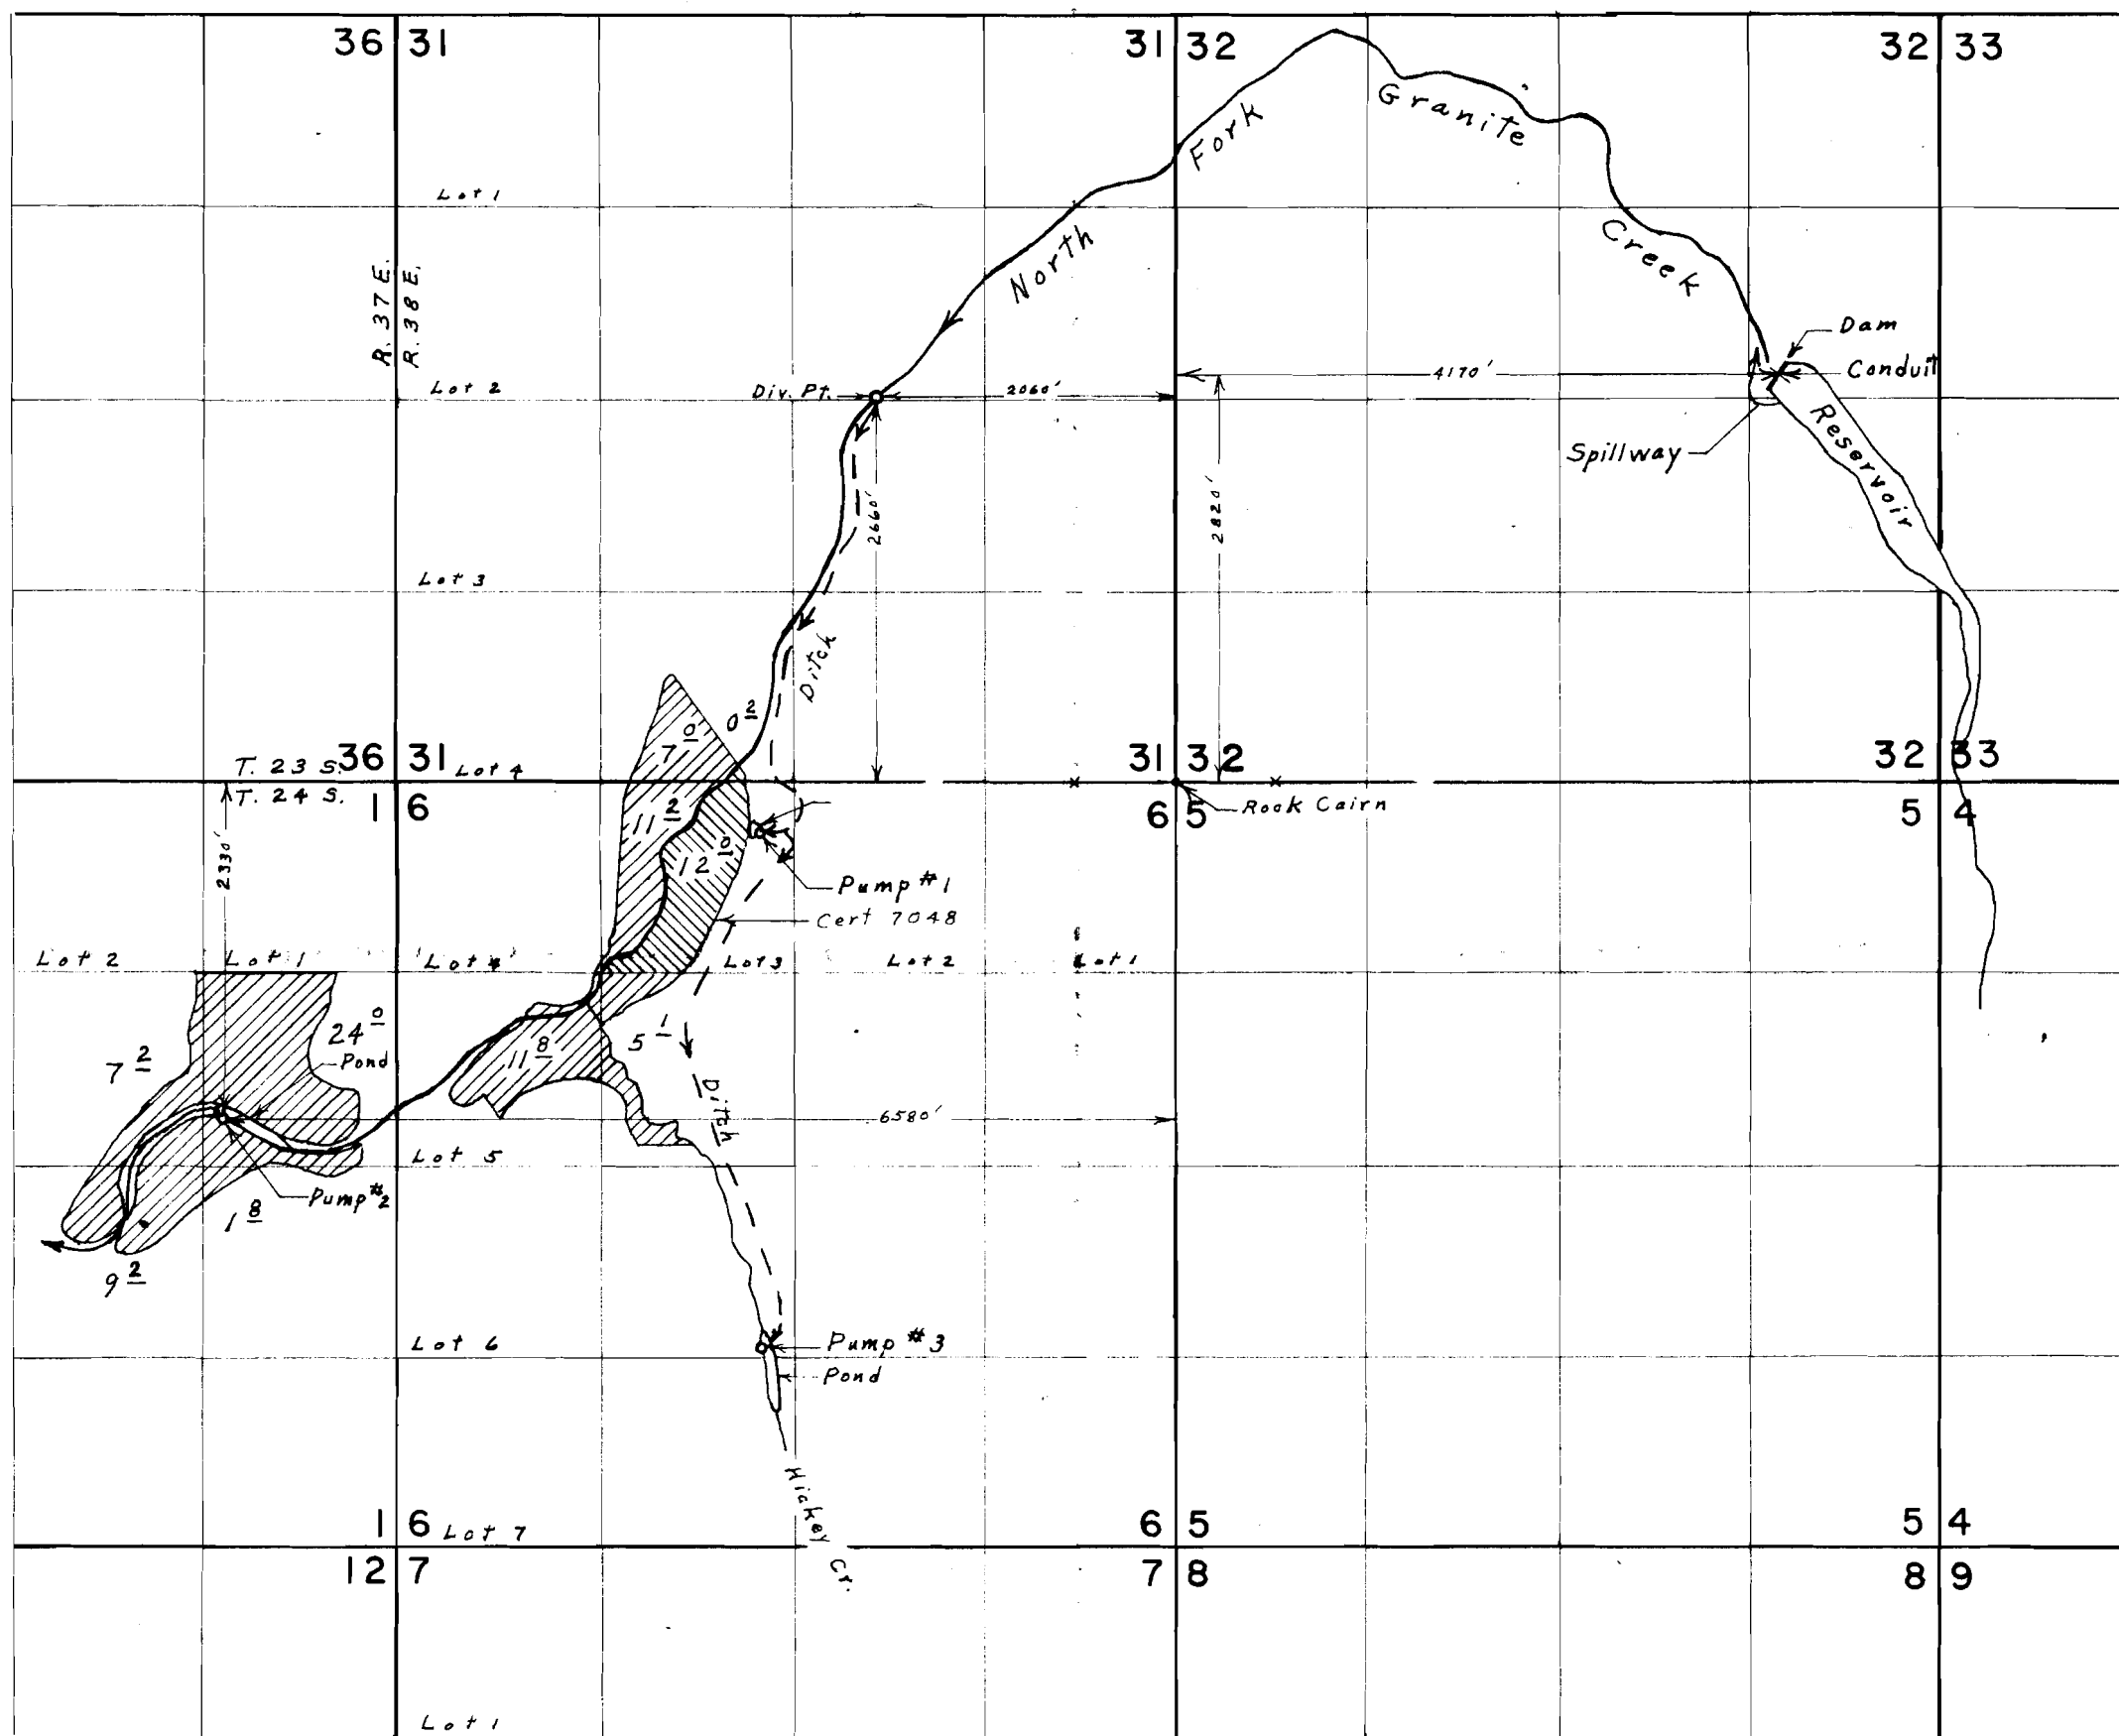

R-33867
33868

R-2356
26743

Aug. 27, 72 L. E. Gould.