


T.23&24S. R.37&38E. W.M.

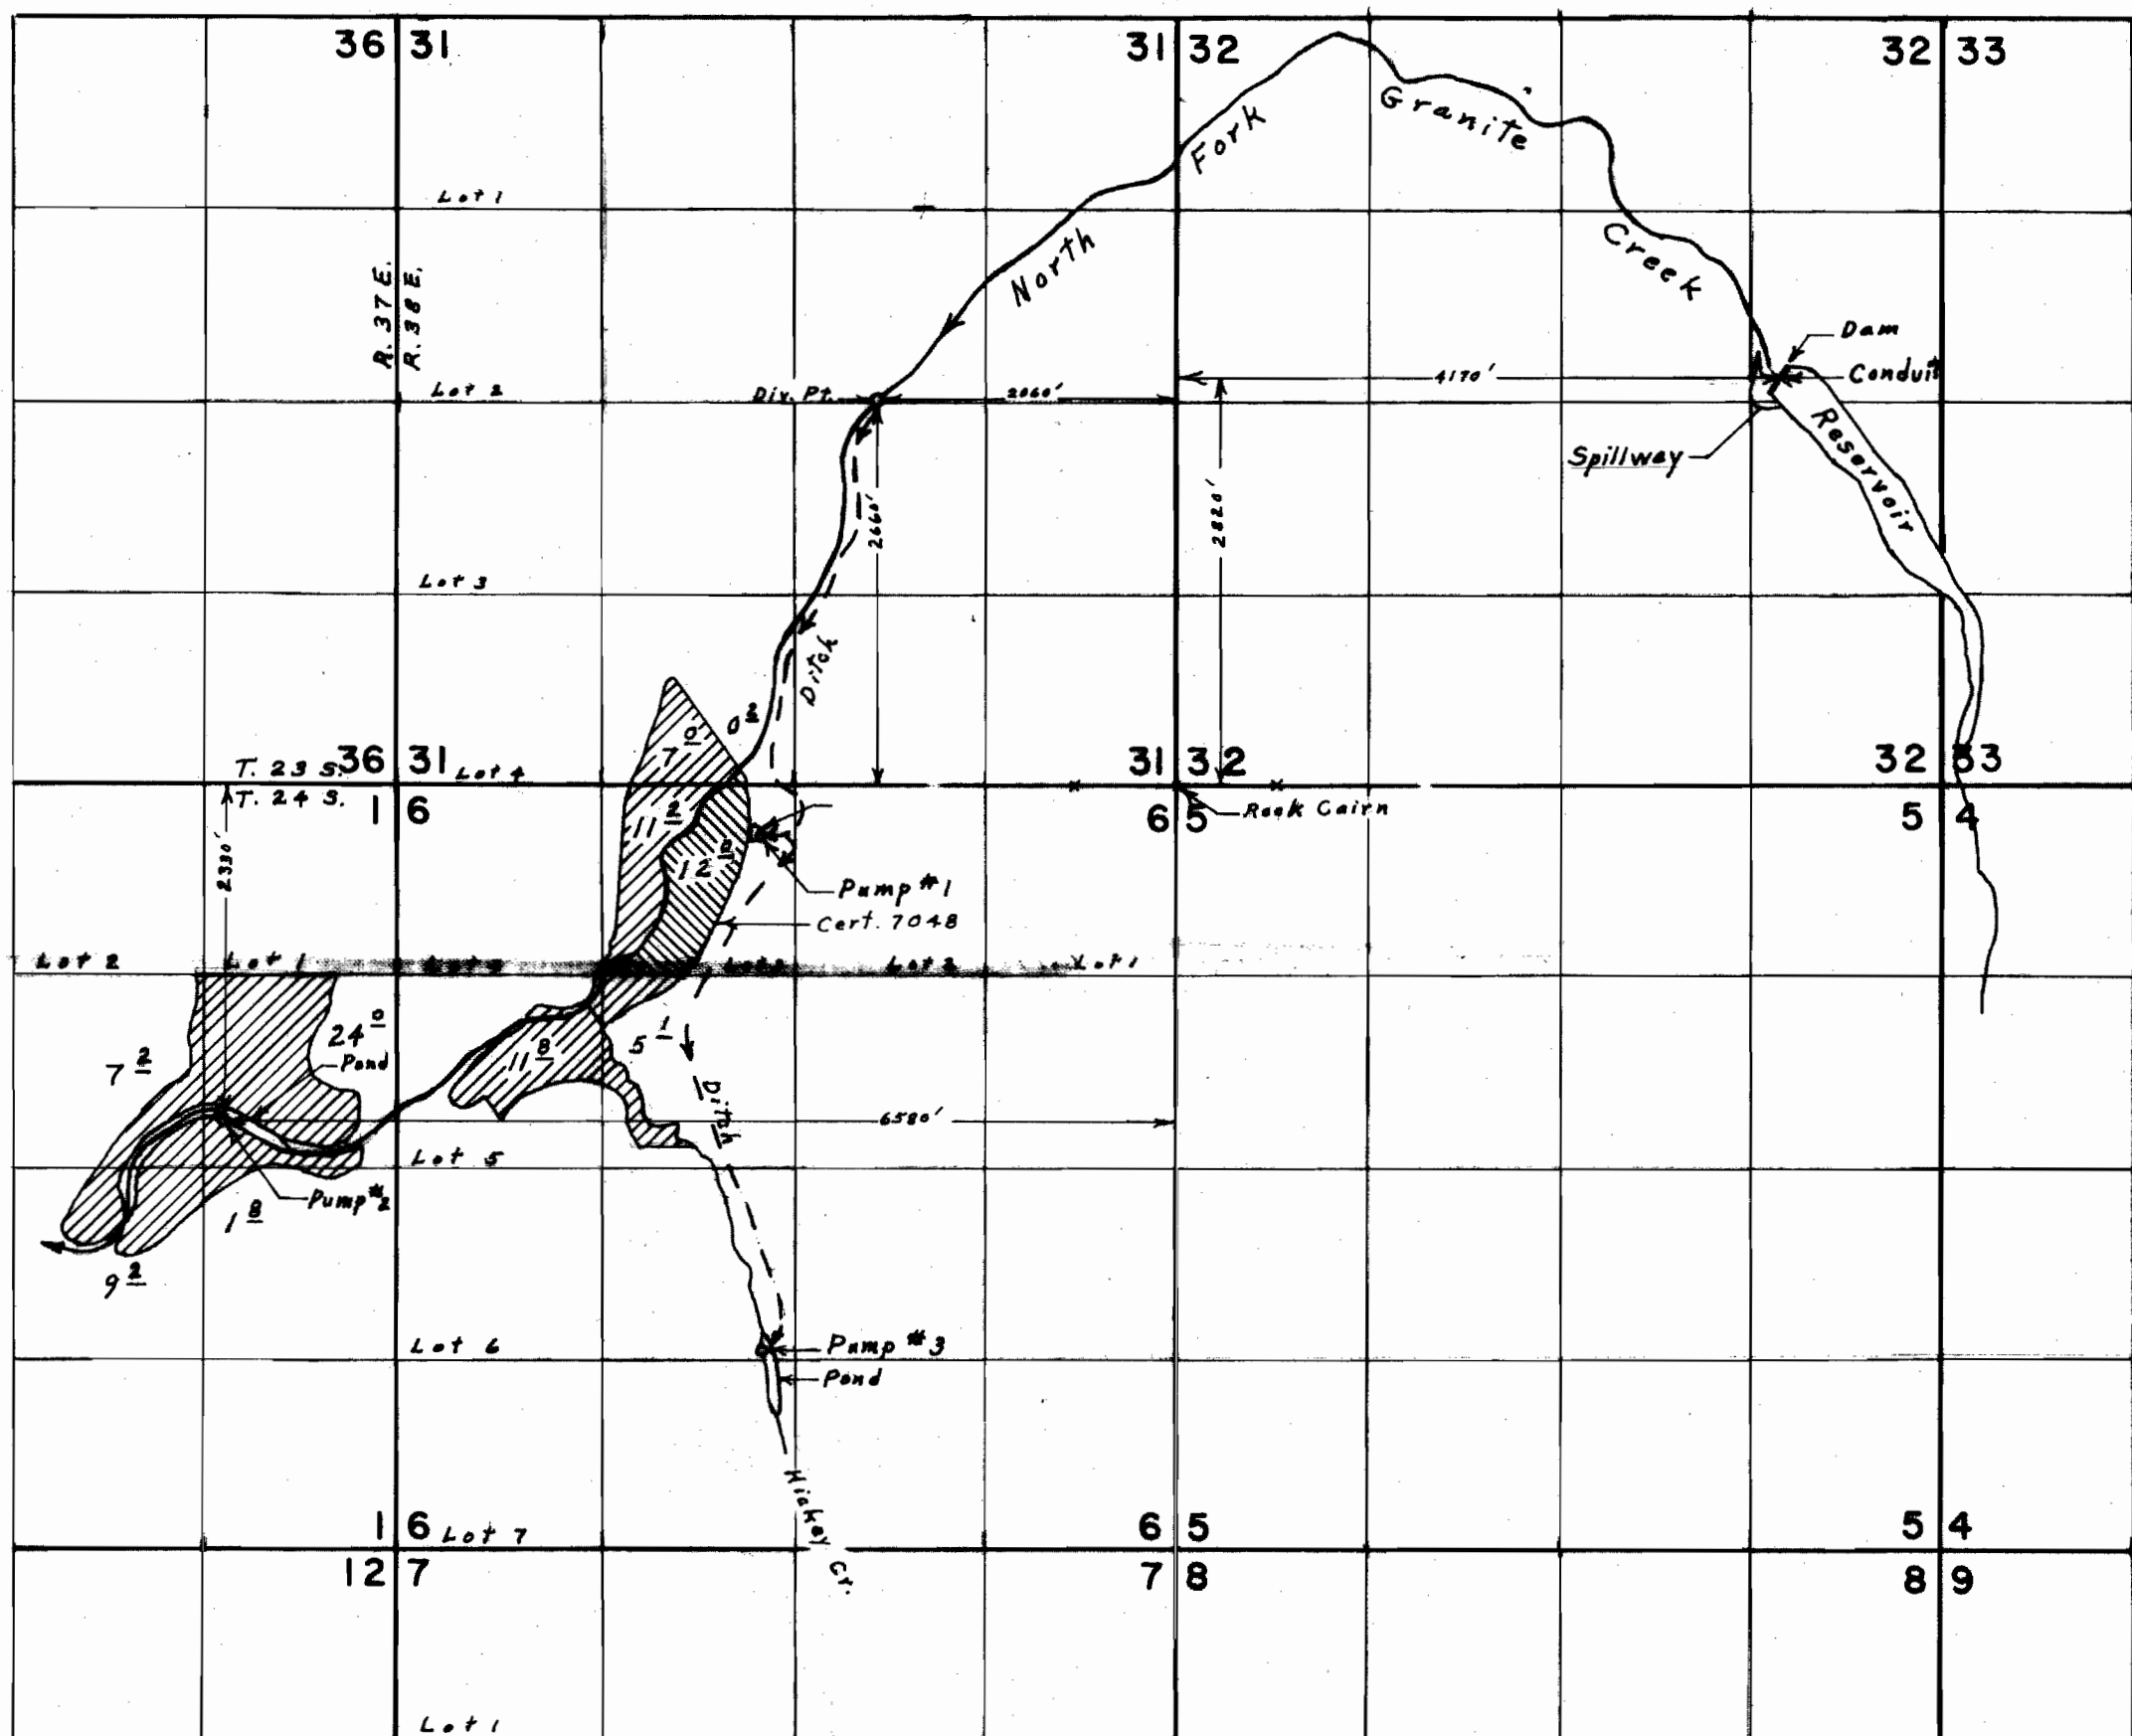

FINAL PROOF SURVEY

UNDER

Application No. R-33867 Permit No. R-2356

IN NAME OF

Surveyed Aug 27, 1972, by L. E. Gould