


T.9S.R.1W.W.M.

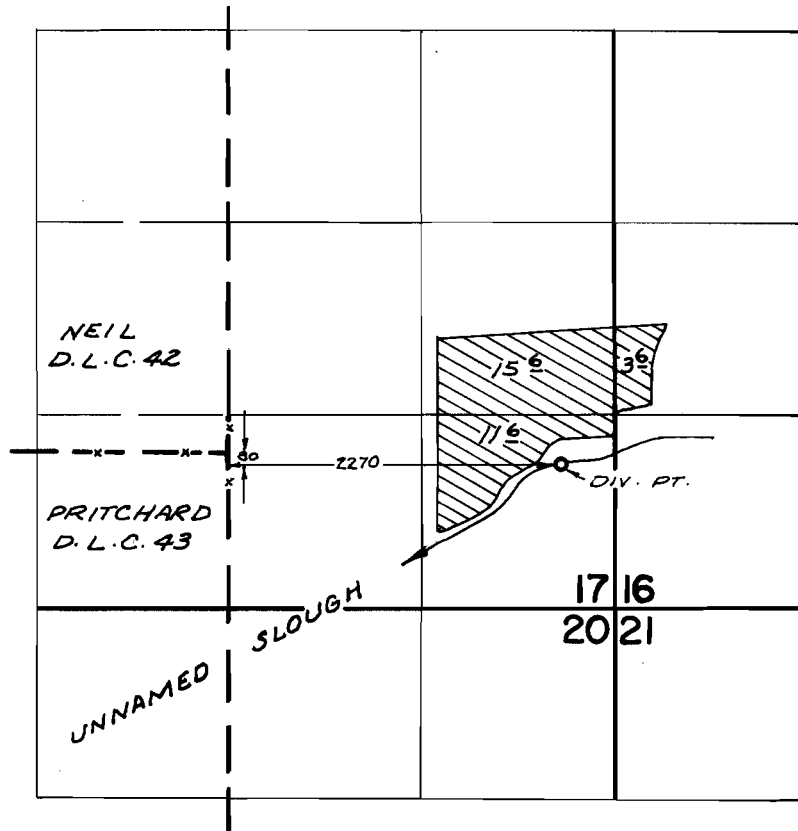

FINAL PROOF SURVEY UNDER

Application No. 40487 Permit No. 30170
IN NAME OF

GEORGE A. E. LUCILLE FERY

Surveyed OCT. 24, 1972, by R. MUCKEN