


T.5S. R.IW. W.M.

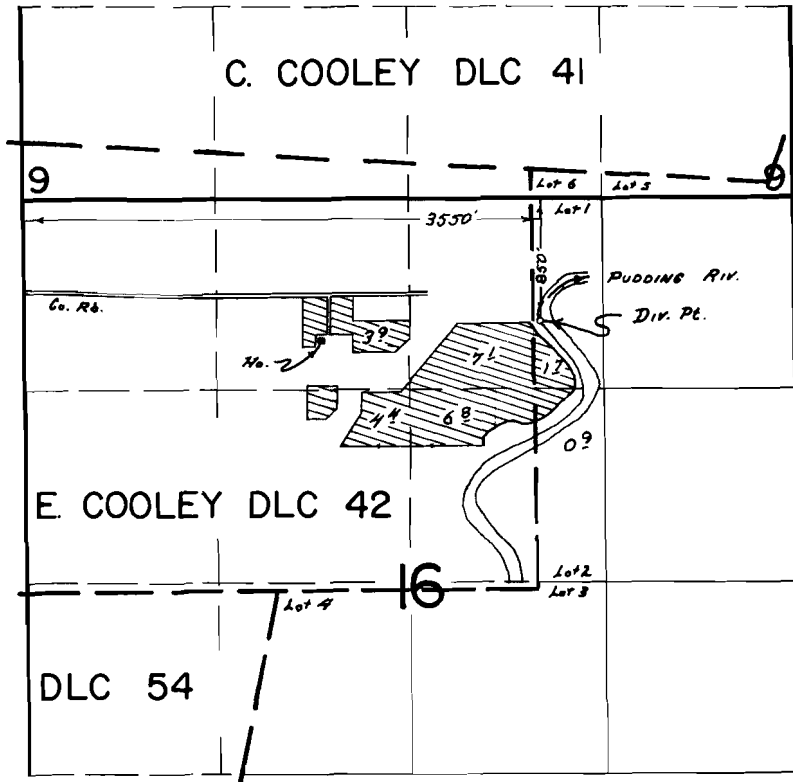

FINAL PROOF SURVEY
UNDER

Application No. 45179 Permit No. 33752
IN NAME OF

EARL A. DOMAN

Surveyed APRIL 24 1973, by R.C. Mucken