


T.6S. R.1W. W.M.

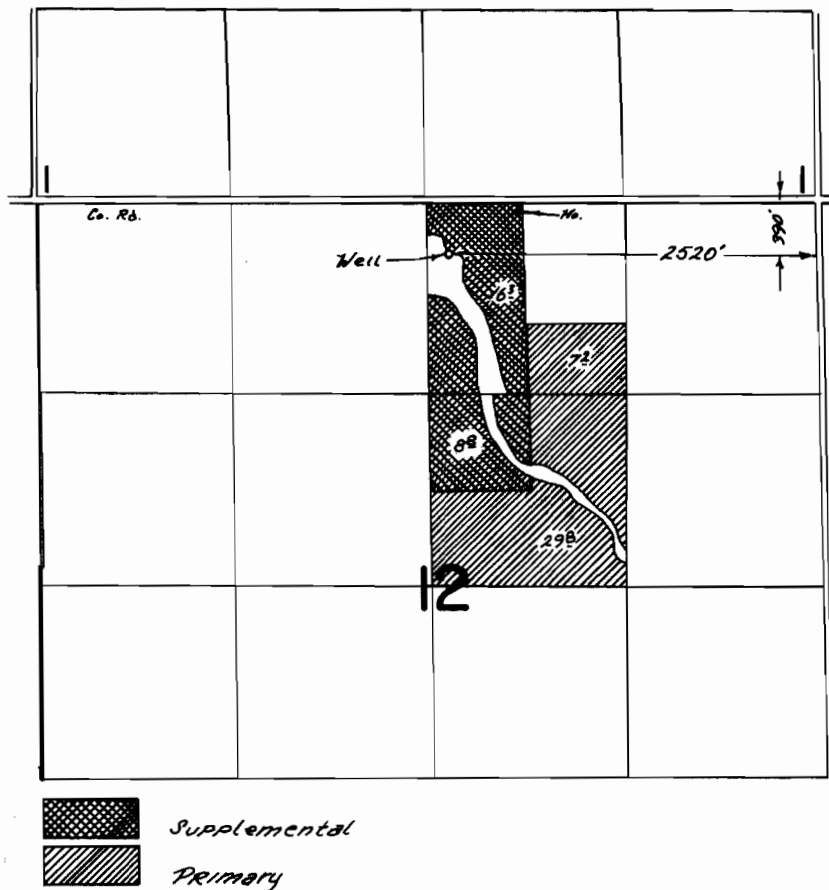

FINAL PROOF SURVEY
UNDER

Application No. B-3279 Permit No. B-3179
IN NAME OF

ERWIN NICKODEMUS

Surveyed April 26 19 73, by R. B. Mucken