T. 6S. R.2&3W. W.M.

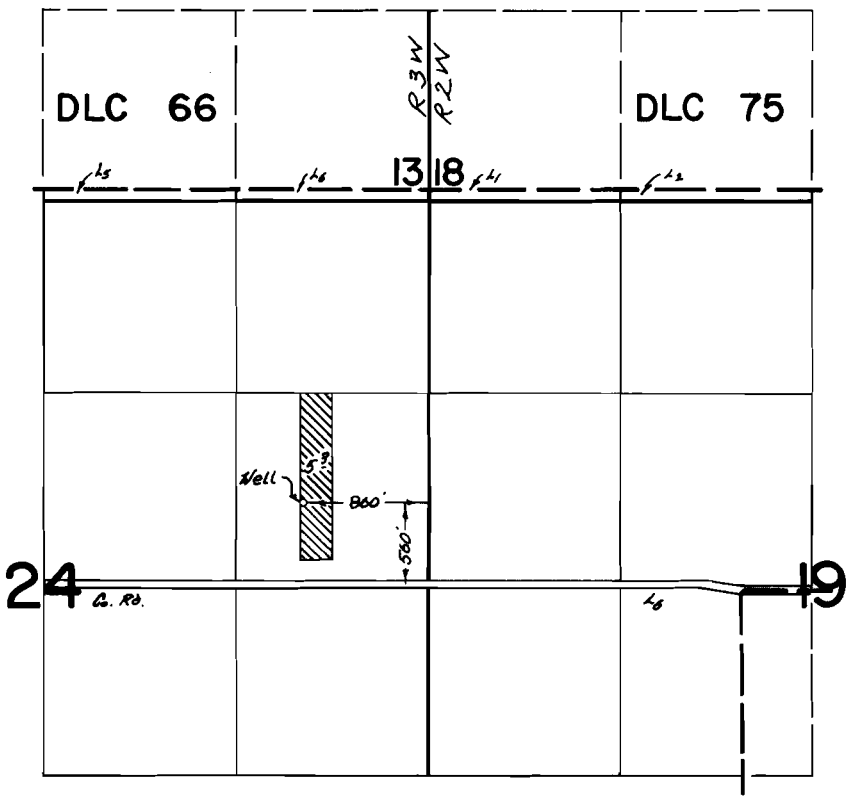

FINAL PROOF SURVEY
UNDER

Application No. G-4197 Permit No. G-3962
IN NAME OF

JACK E. LEE

Surveyed Oct 29 19 72, by R. G. Mucken

DFN-6LL-142 TP