


## T. 4N.R. 35E.W.M.

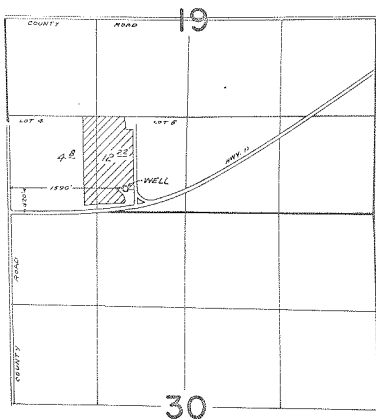

FINAL PROOF SURVEY  
UNDER

Application No. G-3725 Permit No. G-3521  
IN NAME OF

MARVILLE F. SHEARD

Surveyed APR. 19 1973, by R.G. MUCKEN