


T. 4N.R. 34E.W.M.

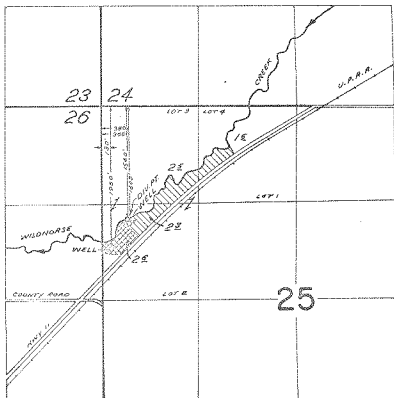

PER. 32168 & G-4002

 PER. 6-3520

FINAL PROOF SURVEY
UNDER

Application No. 43047 Permit No. 32168
G-3724 G-3520
G-4240 G-4002
 IN NAME OF

MARVILLE F. SHEARD

Surveyed APR. 17 1973, by R. G. MUCKEN