


T.6N.R.35&36E.W.M.

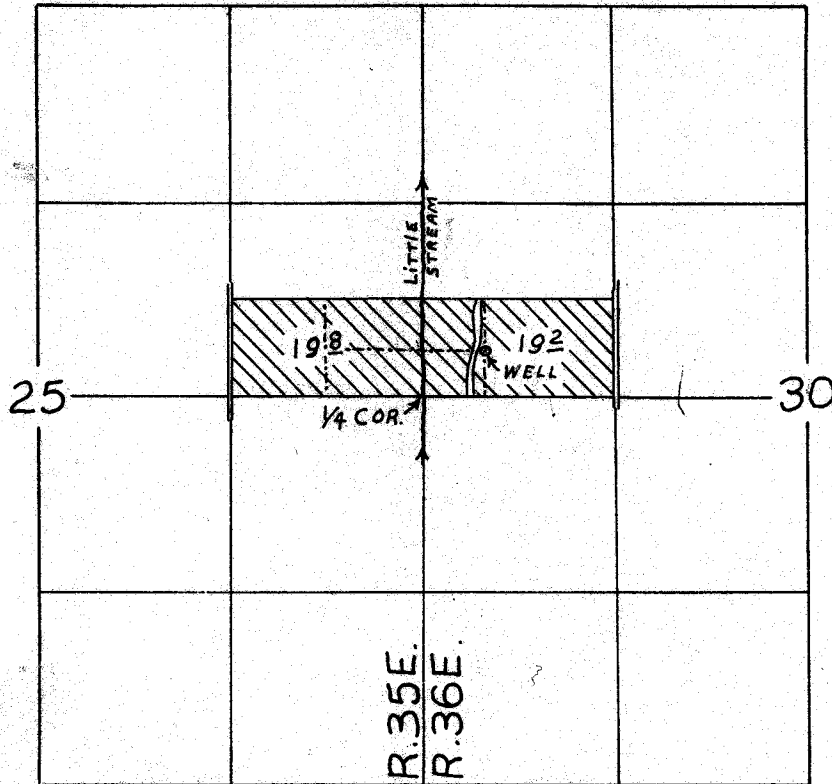

WELL LOCATION:
 320' N., 430' E.,
 W. 1/4 COR., SEC. 30

4" = 1 MILE

MAP TO ACCOMPANY APPLICATION
 TO APPROPRIATE WATER
 SOURCE: A WELL

HAROLD STILLER

Application No. G-4322
 Permit No. G-4080