


G-4720
40814

T.6N.R.34E.W.M.

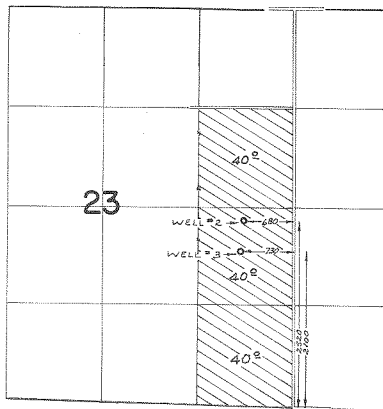

FINAL PROOF SURVEY
UNDER

Application No. G-5002 Permit No. G-4720
IN NAME OF

ESTATE OF ERNEST MULLER

Surveyed APR 16, 1973, by R. MUCKEN