


T. 4 N. R. 35 E. W. M.

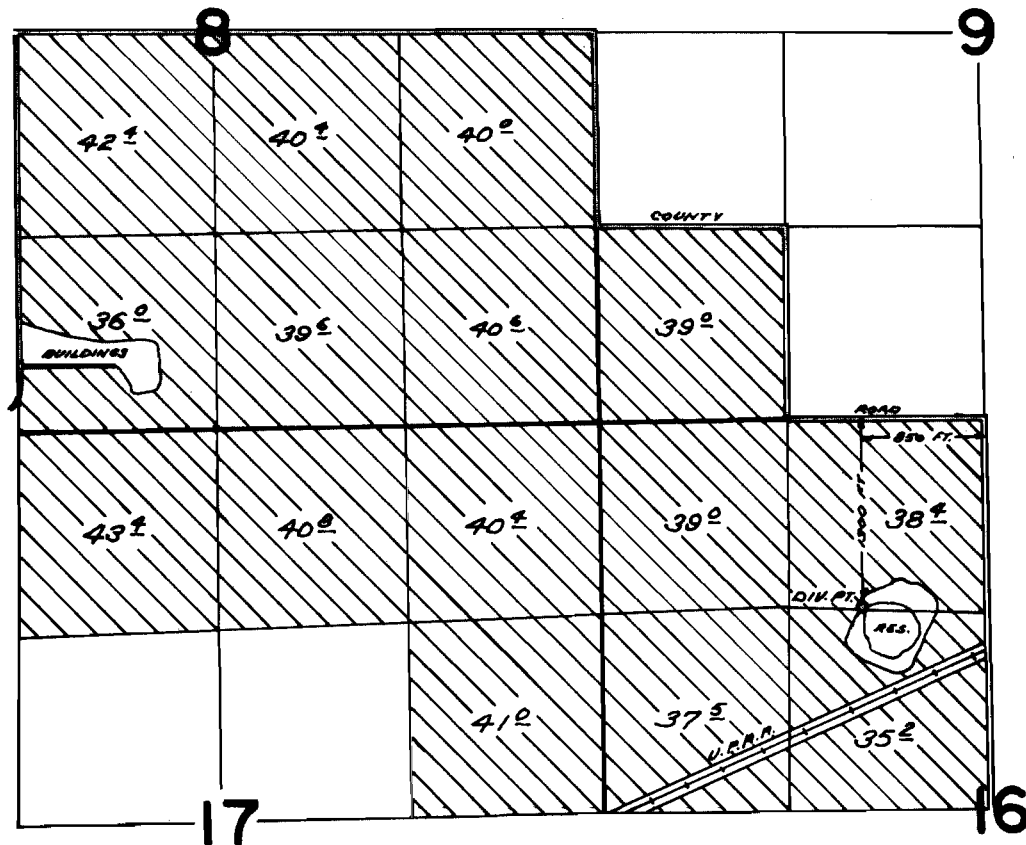

FINAL PROOF SURVEY UNDER

Application No. 40878 Permit No. 30471
IN NAME OF

HANSELL FARMS, c/o WILLIAM HANSELL

Surveyed Apr. 14 1973, by R. G. MUCKEN