


T. 20S. R. 5 W. W.M.

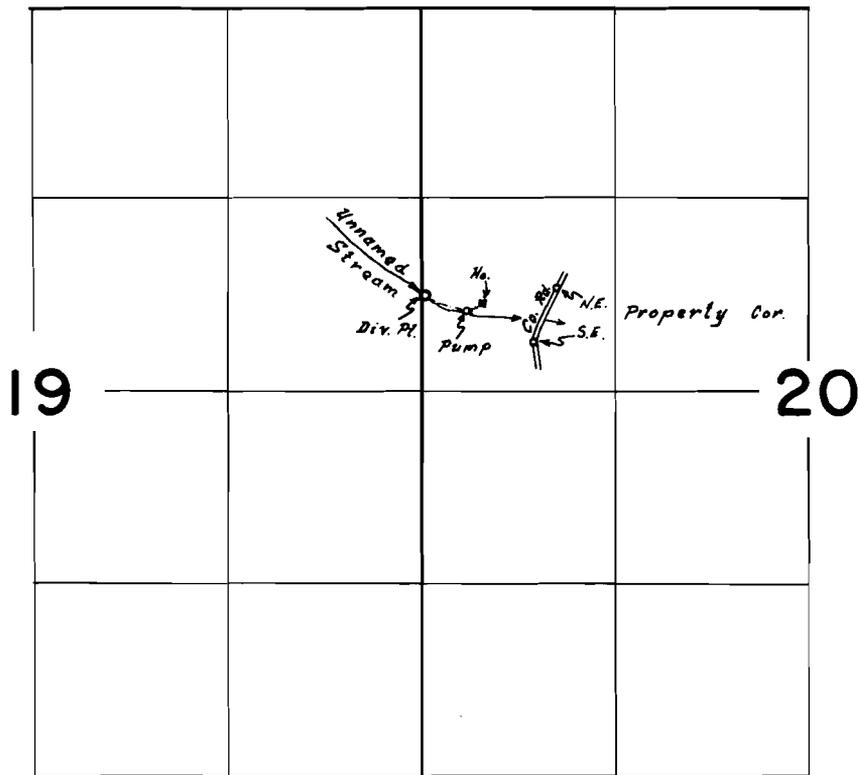

Div. Pt. loc. 670' N. & 30' E. from W. $\frac{1}{4}$ cor. Sec. 20

FINAL PROOF SURVEY
UNDER

Application No. 46002 Permit No 34358
IN NAME OF

Evan C. Mann

Surveyed 1 June, 1972 by L.E. Gould