


T.4N.R.35E.W.M.

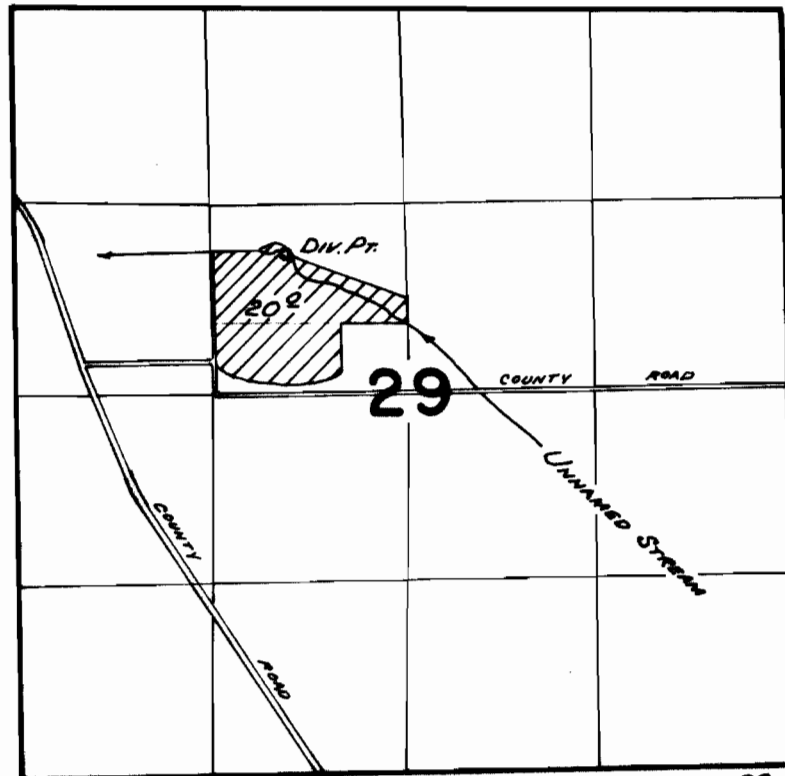

DIV. PT. LOCATED 960 FT. N. AND 820 FT. W. FROM CEN. SEC. 29

FINAL PROOF SURVEY
UNDER

Application No. 47674 Permit No. 35671
IN NAME OF

JAMES H. SAMPSON JR. AND VIOLET SAMPSON

Surveyed Apr. 14 1973, by R. G. MUCKEN