


T.18&2S. R.39E. W.M.

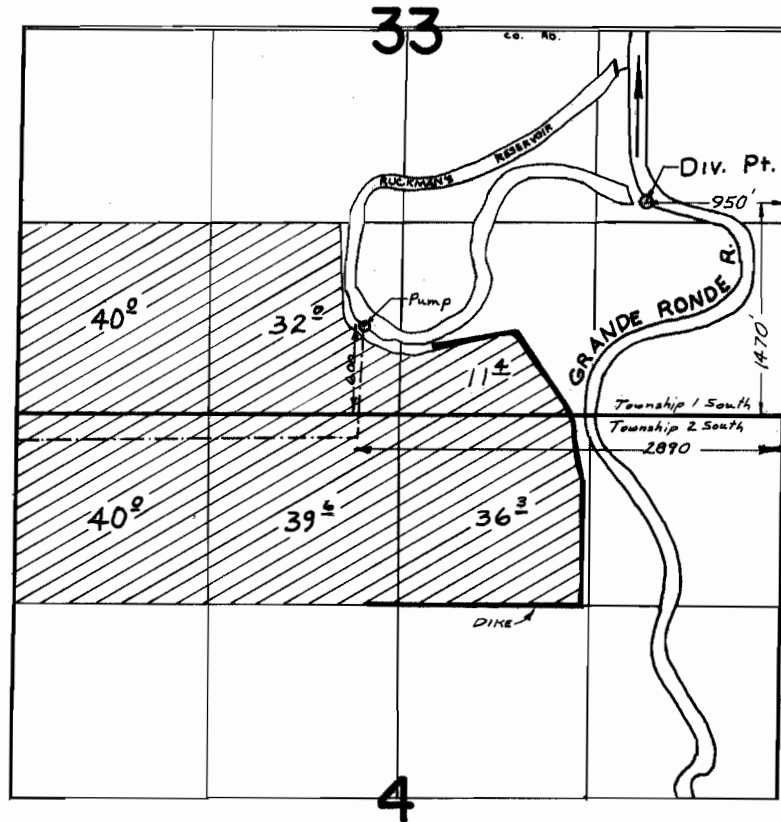

**FINAL PROOF SURVEY**  
UNDER

38857                      29200  
Application No. R-38856    Permit No. R-3883  
IN NAME OF

GAIL TALBOTT

Surveyed JULY 16, 1973, by R. G. MUCKEN