


T.2S. R.1W. W.M.

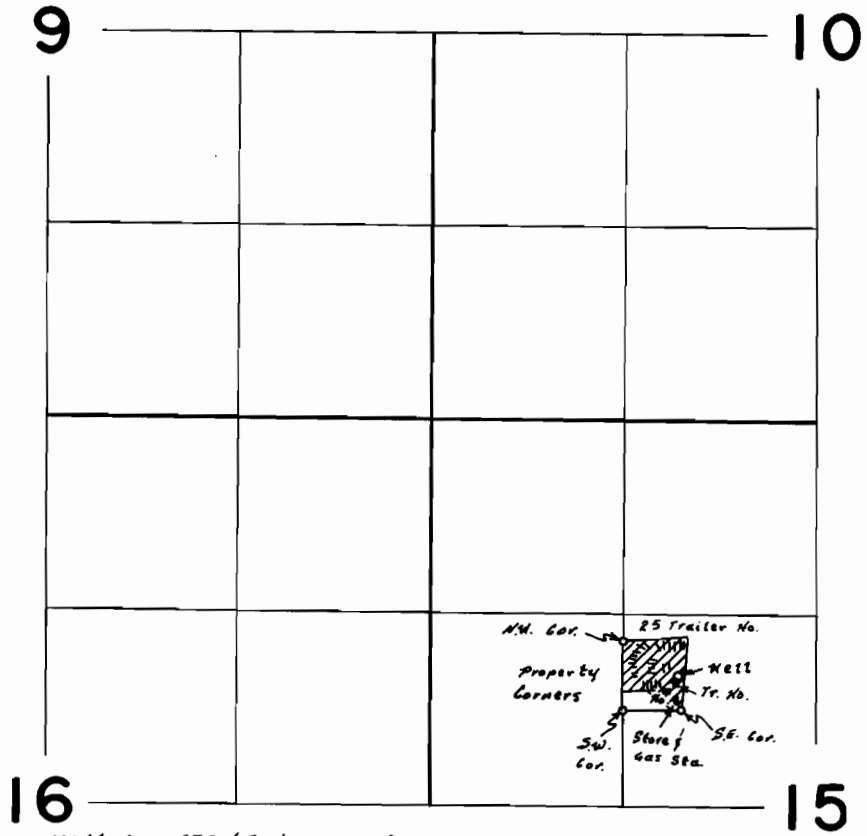

Well loc. 1750'S. & 1700E. from NE. Cor. Sec. 15

FINAL PROOF SURVEY
UNDER

Application No. G-3510 Permit No. G-3304
IN NAME OF
T. C. Wasson

Surveyed 2 Oct. 1972, by L. E. Gould