


T.2S.R.1W.W.M.

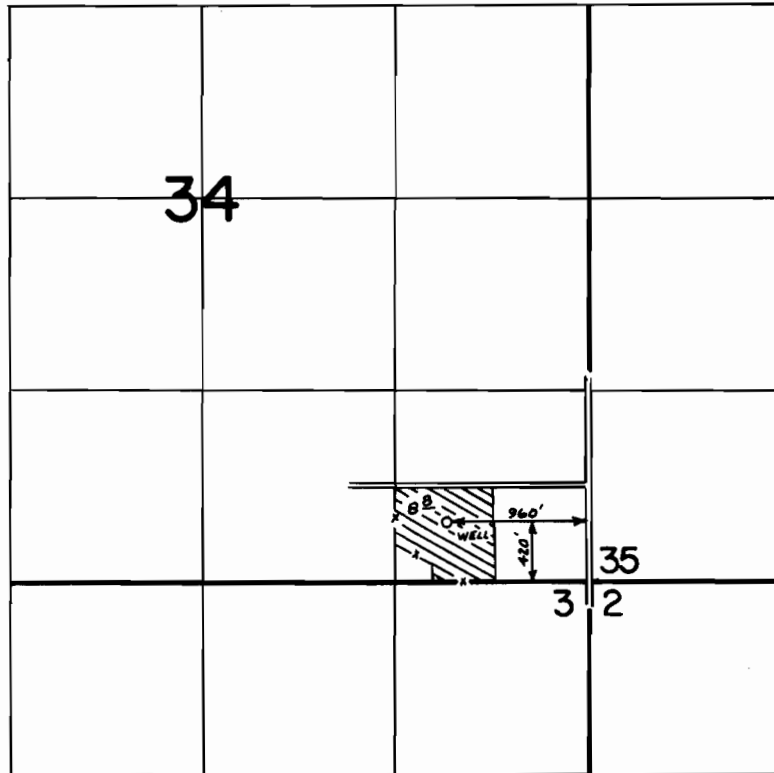

FINAL PROOF SURVEY
UNDER

Application No. G-3619 Permit No. G-3402
IN NAME OF

BRADLEY BRISCOE SUMMERS

Surveyed MAY 16 1973, by R.G. MUCKEN