T. 1 S., R. 3 W., W.M.

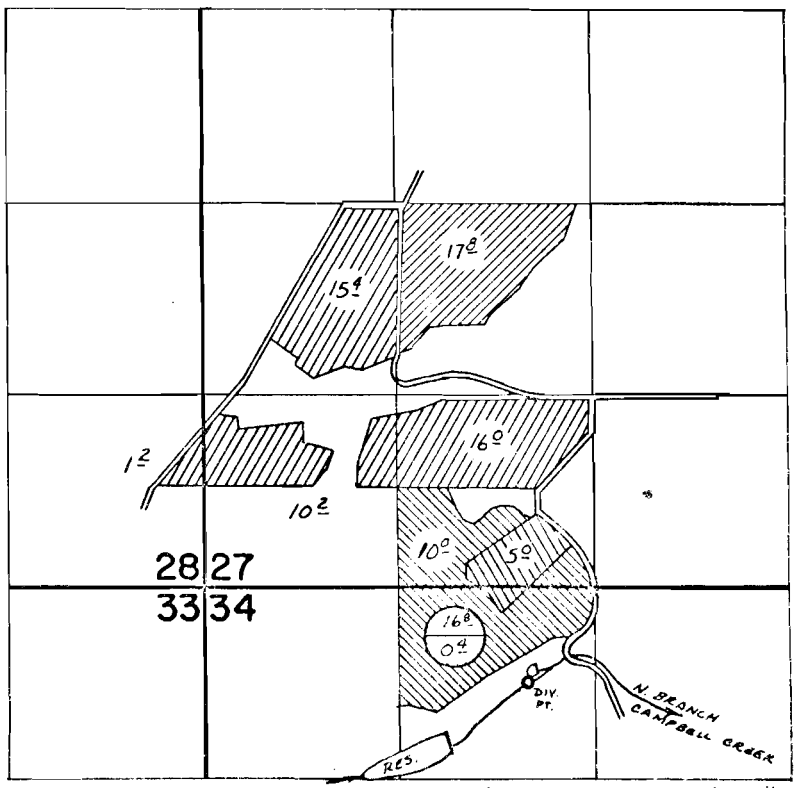

DIV. PTS. LOCATED: RESERVOIR - 2380' S & 990' W FROM NE COR. SE¼ SW¼ SEC. 27.
CREEK - 1960' S & 460' W FROM NE COR SE¼ SW¼ SEC. 27.

PRIMARY A # 42097

PRIMARY A # 41048

SUPPLEMENTAL - STORED WATER ONLY

SUPPLEMENTAL - N. BRANCH CAMPBELL CREEK & RESERVOIR

FINAL PROOF SURVEY

UNDER

R-41140 R-4663

Application No. 41048 42097 Permit No. 30882 31710

IN NAME OF

JOHN F KOEHNKE

Surveyed June 16 1972, by D. Norby

DFR-20-163
PTS-1959-M
PTS-1960-K
PTS-1972-A