


T.1S.R.2W.W.M.

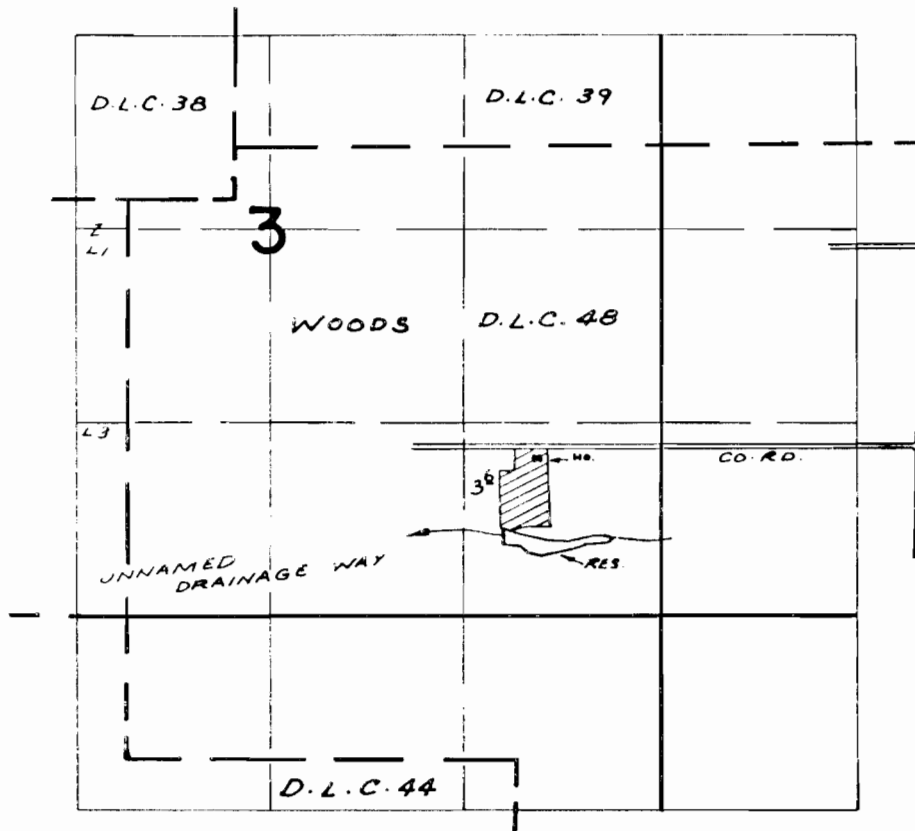

DIV PT LOC. 2660' S & 2820' W FROM N.E. COR. WOODS D.L.C. 48

FINAL PROOF SURVEY UNDER

R-43998 R-5072
Application No. 43999 Permit No. 32894
IN NAME OF

AV. & IDA B. PETERSON

Surveyed Oct. 30, 1972, by R. MURKEN