


T.3N.R.3W.W.M.

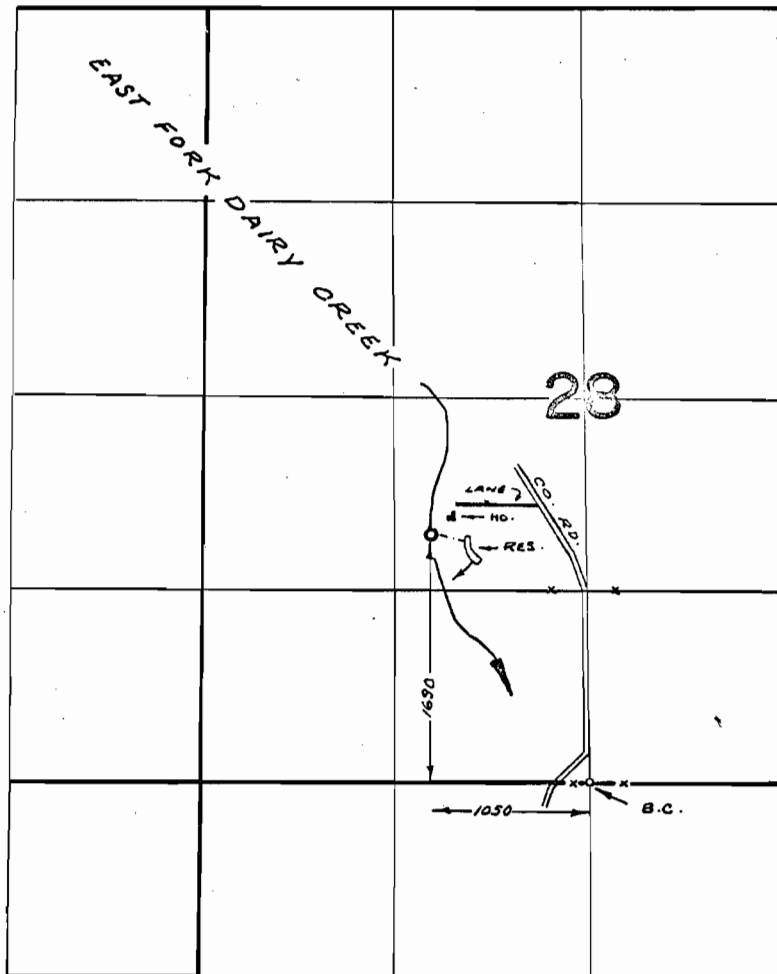

FINAL PROOF SURVEY
UNDER

Application No. R-44041 44042 Permit No. R-5076 32914
IN NAME OF

GORDON S. LEWIS

Surveyed SEPT 25 1972, by R. MUCKEN