


T. 3N.R. 4W. W.M.

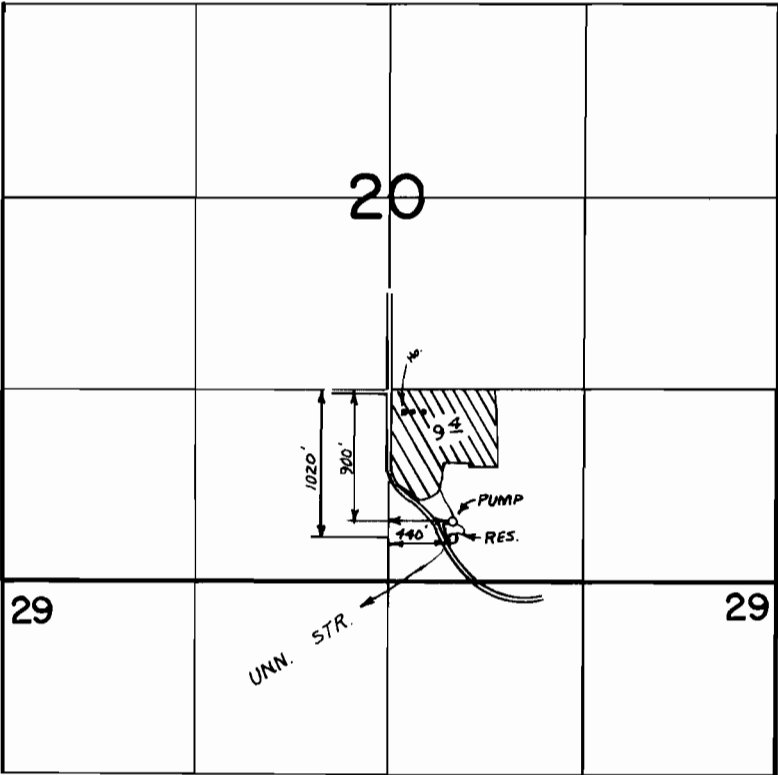

FINAL PROOF SURVEY
UNDER

R-44046 *R-5077*
Application No. 44212 Permit No. 32931
IN NAME OF

LUTHER NOBLE

Surveyed JUN 27 1973, by R.G. MUCKEN