


T.1 N.R.4W. W.M

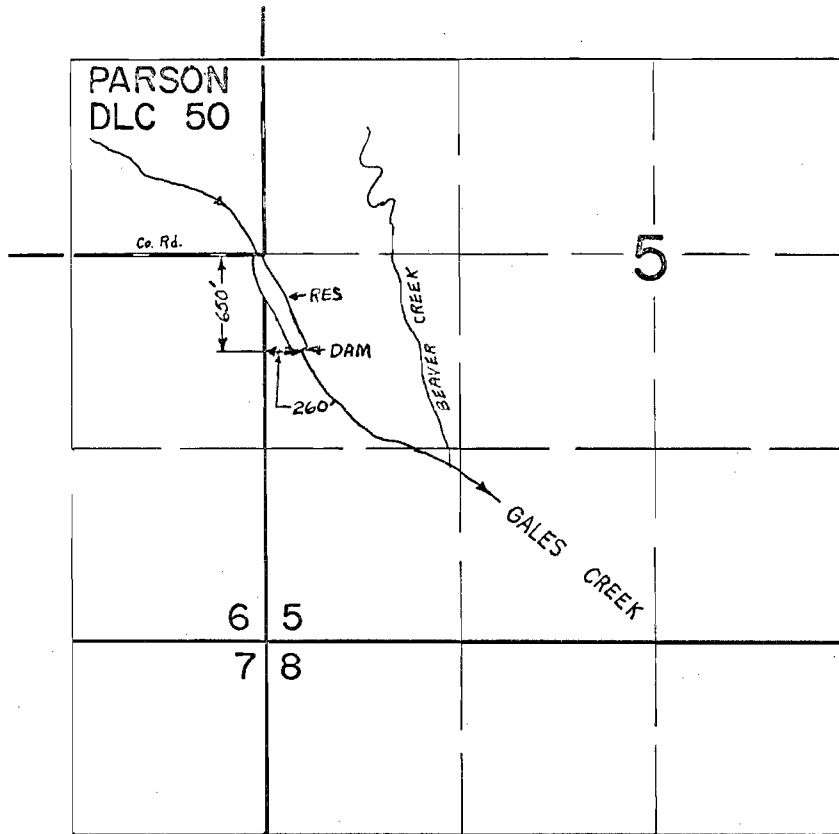

FINAL PROOF SURVEY UNDER

Application No. 47566 R-47565 Permit No. 35613 R-5730
IN NAME OF

JENNINGS F. JAGER

Surveyed JUN 8 1972, by L. GOULD