


T.17S. R.10W.,W.M.

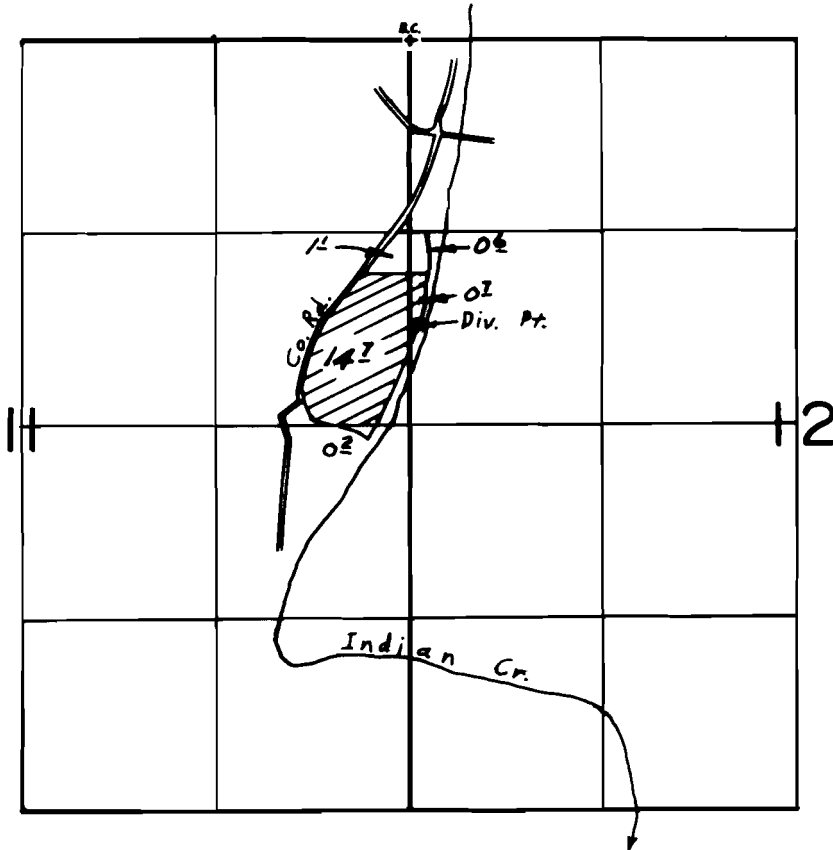

Div. Pt. Loc. 1950' S. & 50' E. From N.E. Cor. Sec. 11.

FINAL PROOF SURVEY
UNDER

Application No. 53913.... Permit No. 40225....
IN NAME OF

.....**LARRY BEERS**.....

Surveyed **AUG. 25, 1977,** by **B.R. SUND**.....