T.1S., R.3W., W.M.

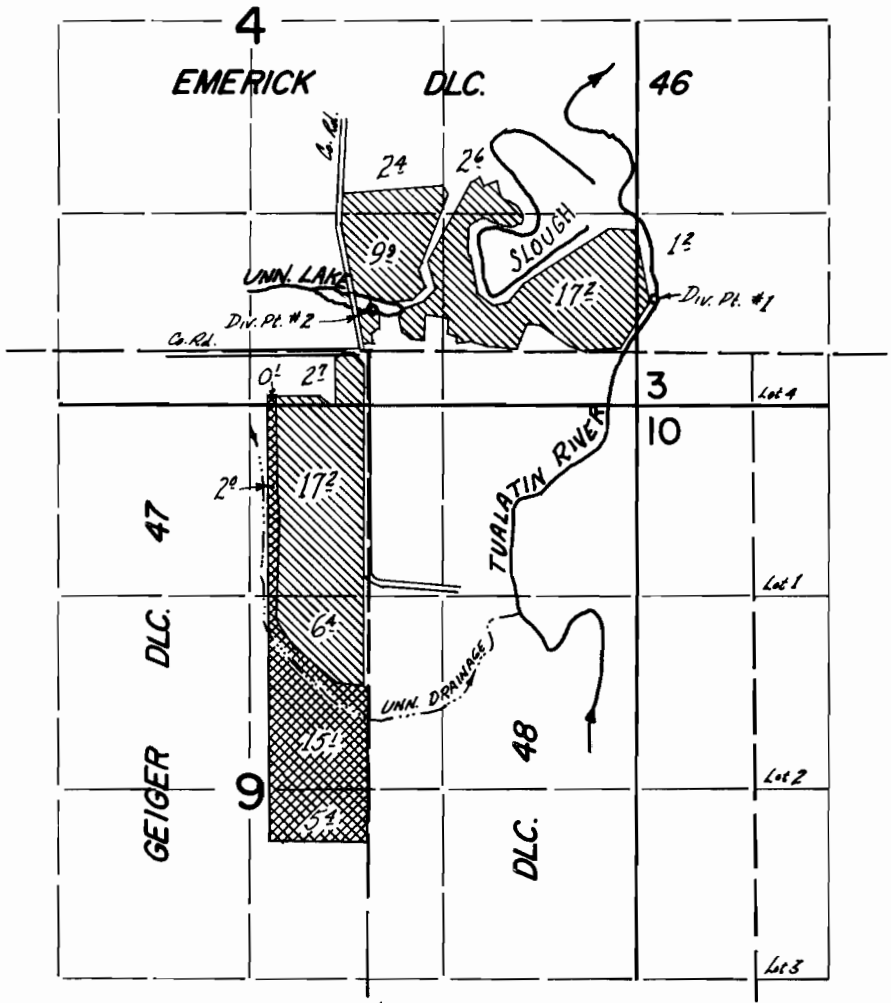

Div. Pts. located: #1 - 260 ft. N. & 20 ft. E.; #2 - 350 ft. N. & 1950 ft. E., both from NE cor. Geiger DLC. 47.

Primary — (River) Supplemental — (Lake)

FINAL PROOF SURVEY
UNDER

Application No. 43248 Permit No. 32248
IN NAME OF

JOHN V. & LILLIAN J. ELSBERRY

Surveyed 14 June 1972, by D. Norby

DFR-50-07