


T. 1 N., R. 4 W., W.M.

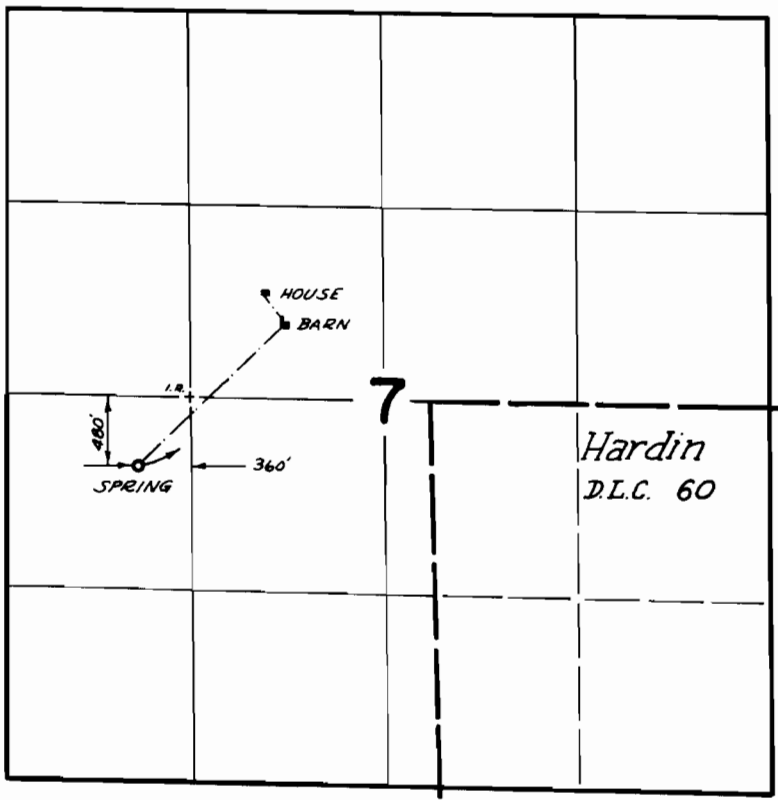

FINAL PROOF SURVEY
UNDER

Application No. 46822 Permit No. 35014
IN NAME OF

DIXIE CULVER & ECHO LARSON

Surveyed June 9 1972, by L.E. Gould