


T.1N.,R.4W.,W.M.

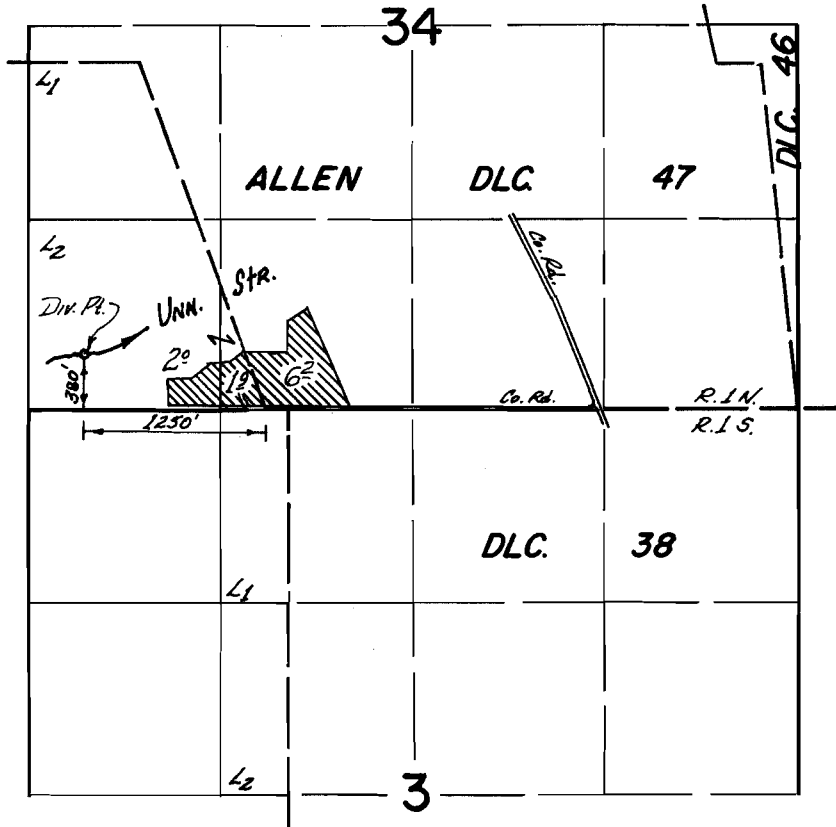

FINAL PROOF SURVEY
UNDER

Application No. 48516 Permit No. 36401
IN NAME OF

RUTH C. & A. V. JACKSON

Surveyed JUNE 25 19 73, by D. NORBY