


T23SR. 5 E.W.M.

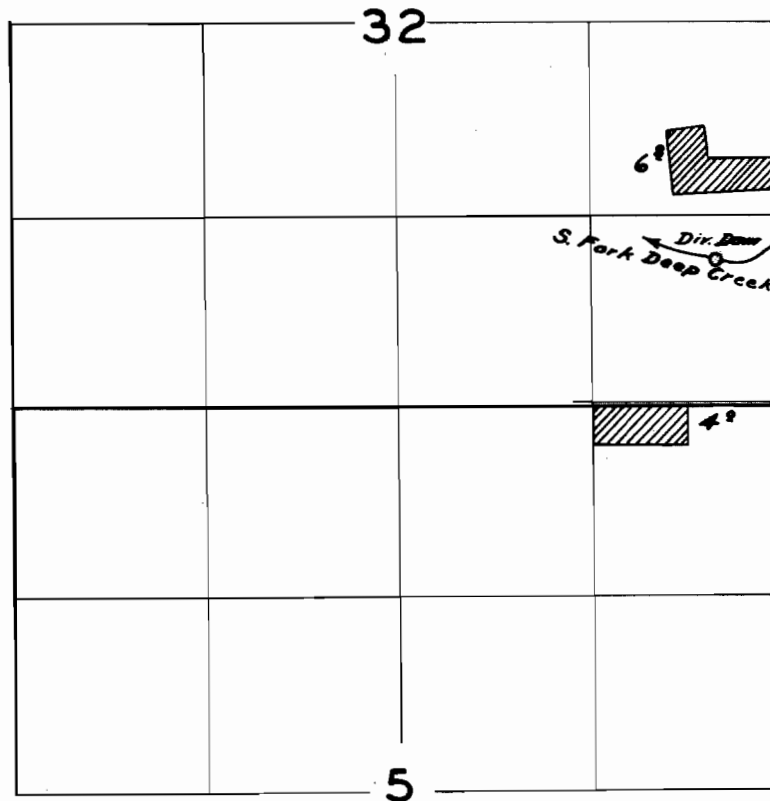

FINAL PROOF SURVEY

UNDER

Application No. 17555 Permit No. 13258
IN NAME OF

Mrs. SUSAN KELLNER

Surveyed June 19, 1956, by R.H. Whitby

DEX-16-76
Pantograph
CB.