


T. 15. R. 3 W. W. M.

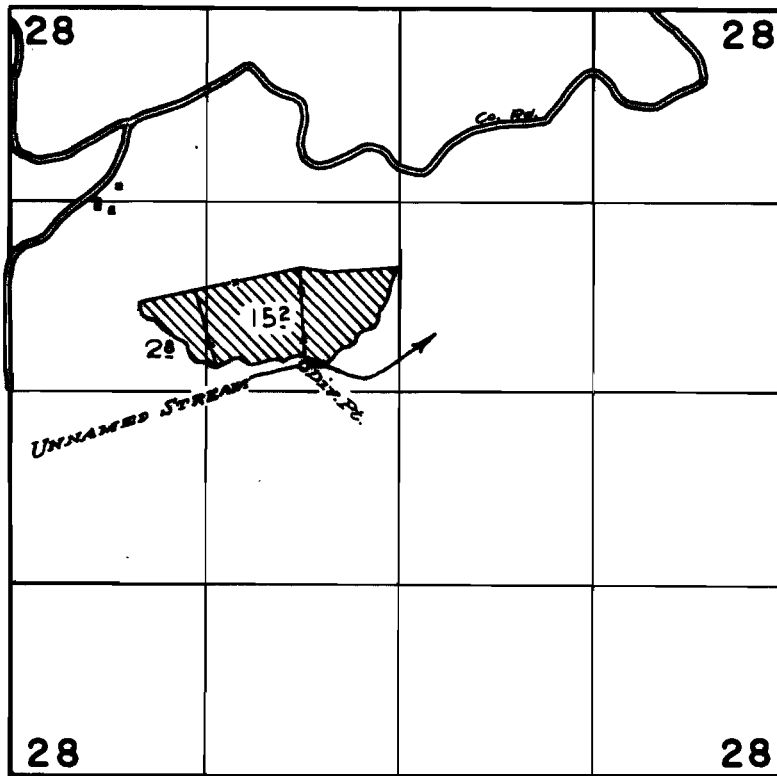

FINAL PROOF SURVEY UNDER

Application No. 29680... Permit No. 2337.2.
IN NAME OF

..... W. L. NELSON

Surveyed June 20 1960, by

[Handwritten Signature]