


T.2S. R.1 W. W.M.

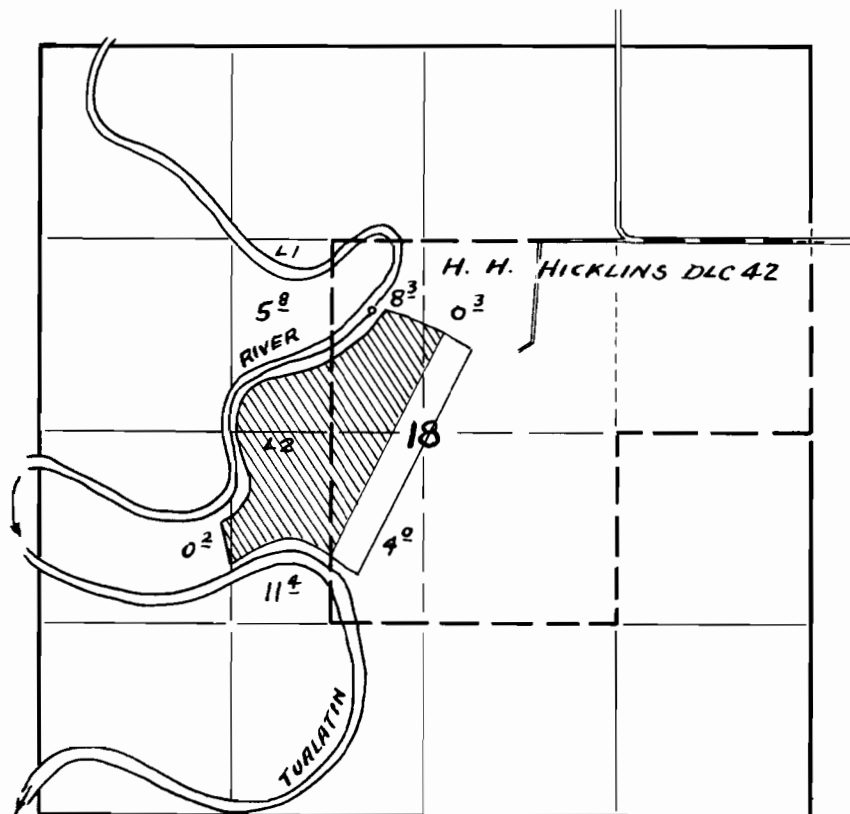

FINAL PROOF SURVEY

UNDER

Application No. 25704 Permit No. 20250
IN NAME OF

ELSNER BROTHERS

Surveyed 5-10 1956, by R.H. WHITBY