


T.2S. R.1W. W.M.

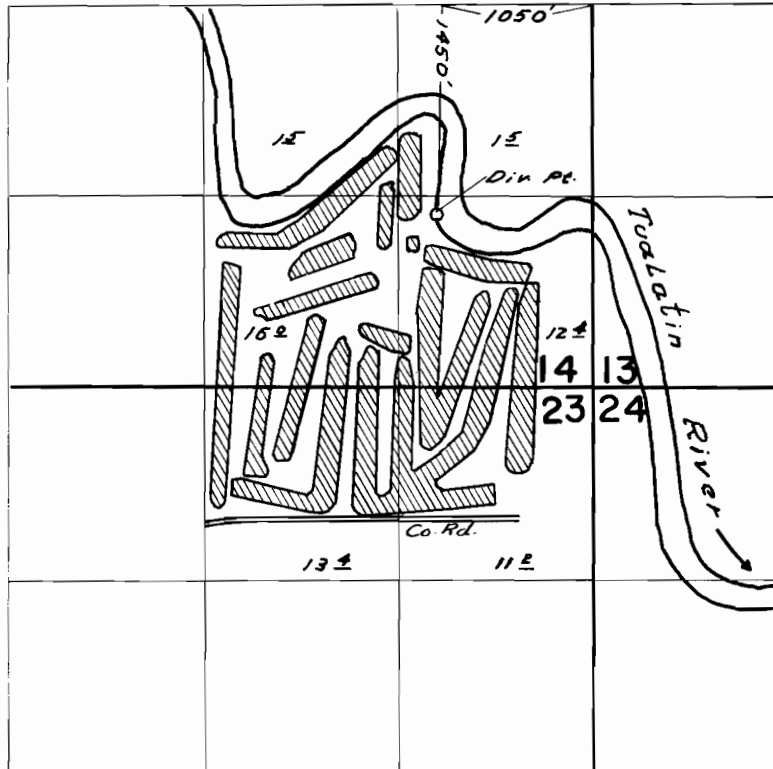

FINAL PROOF SURVEY UNDER

Application No. 39710 Permit No. 29544
IN NAME OF

TUALATIN COUNTRY CLUB

Surveyed MAY 4 1965, by L. COLEBANK