


T.4S.R.2W.W.M.

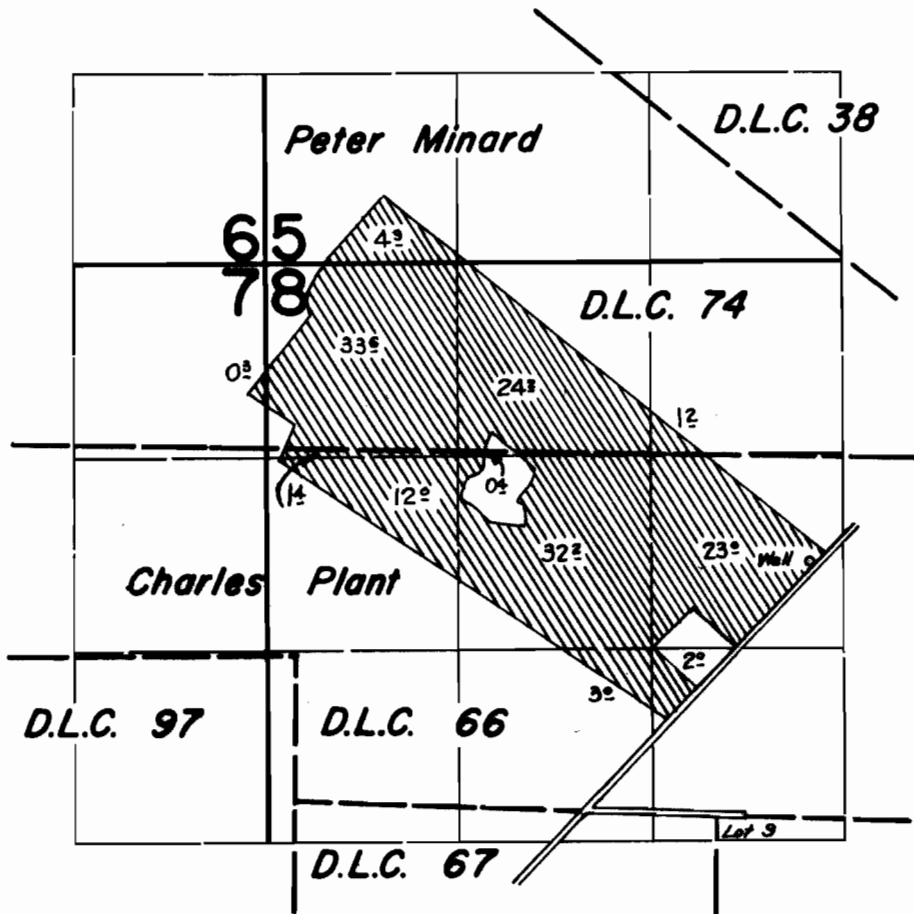

FINAL PROOF SURVEY UNDER

Application No. G-1806... Permit No. G-1651...
IN NAME OF
NELSON C. & HOWARD O. TRIBBETT
dba **TRIBBETT AND SON**

Surveyed March 22 1962, by