


# T. 9 S. R. 45 E. W.M.

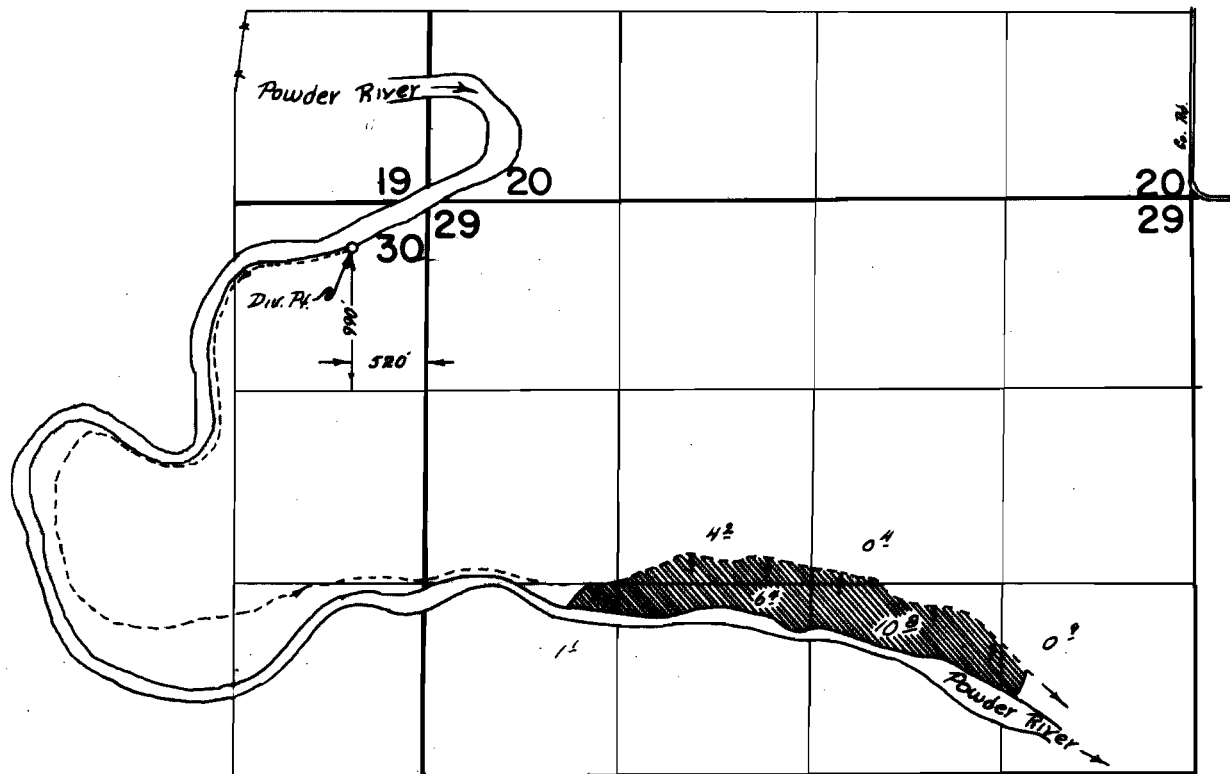

## FINAL PROOF SURVEY UNDER

Application No. 41328 Permit No. 30858  
IN NAME OF

DAVID DENNIS

Surveyed June 21 1972, by R. B. Mucken