


T.11S., R.5W., W.M.

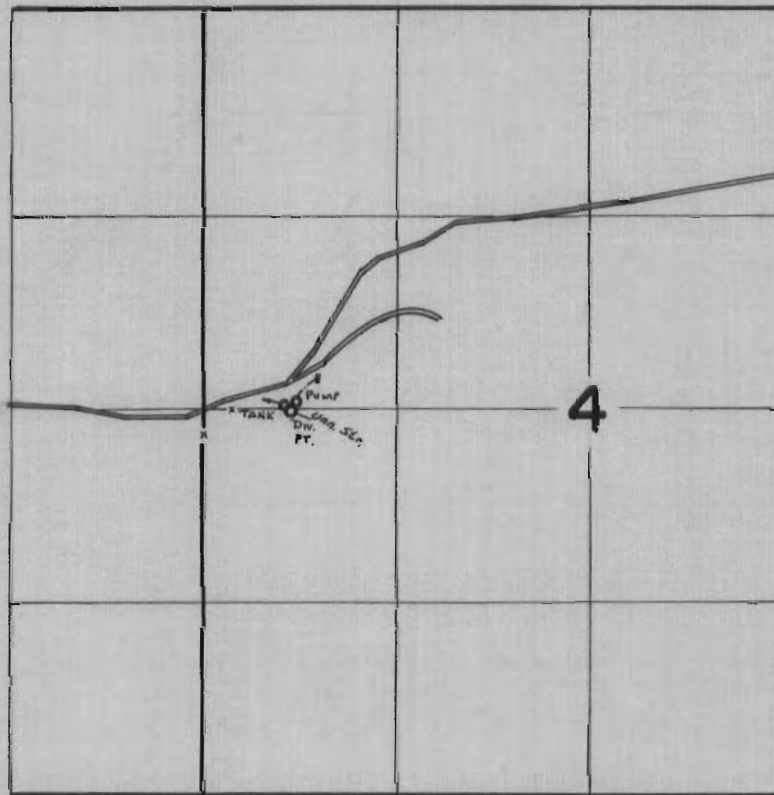

DIV. PT. LOCATED: 10'S & 600'E FROM W 1/4 COR. SEC 9.

**FINAL PROOF SURVEY**  
UNDER

Application No. 47721 Permit No. 35747  
IN NAME OF

CARL D. WAGNER

Surveyed Aug 18 1972, by D. Norby