


T. 2 S. R. 4 & 5 E. W.M.

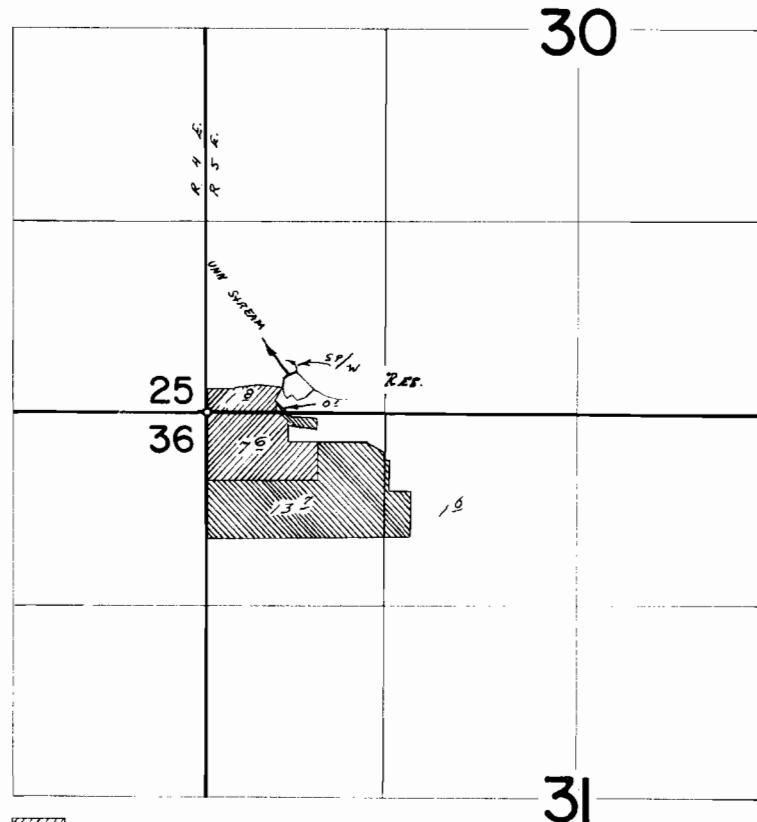

SUPPLEMENTAL CERT. 22586
PRIMARY

DIV. LOC. 260' N. & 570' E. FROM SW COR SEC. 30

FINAL PROOF SURVEY
UNDER

TRANSFER H- 172
R- 42483
Application No. 12484 Permit No. 32262
IN NAME OF

WARREN W. HARDING

Surveyed MAY 25 1972 by R. G. MUCKEN